


T.17 S.R.2 W.W.M.

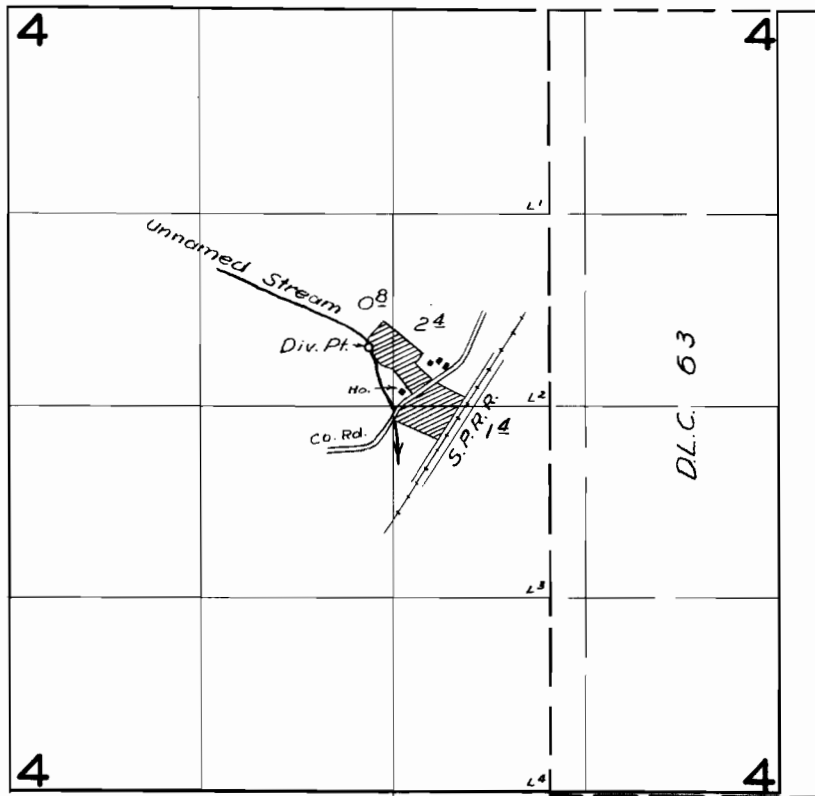

FINAL PROOF SURVEY

UNDER

Application No. 29032 Permit No. 22841

IN NAME OF

Chas. O. Stephens

Surveyed *May 7, 1957*, by *M. Bish*