


T.18S.R.5W.W.M.

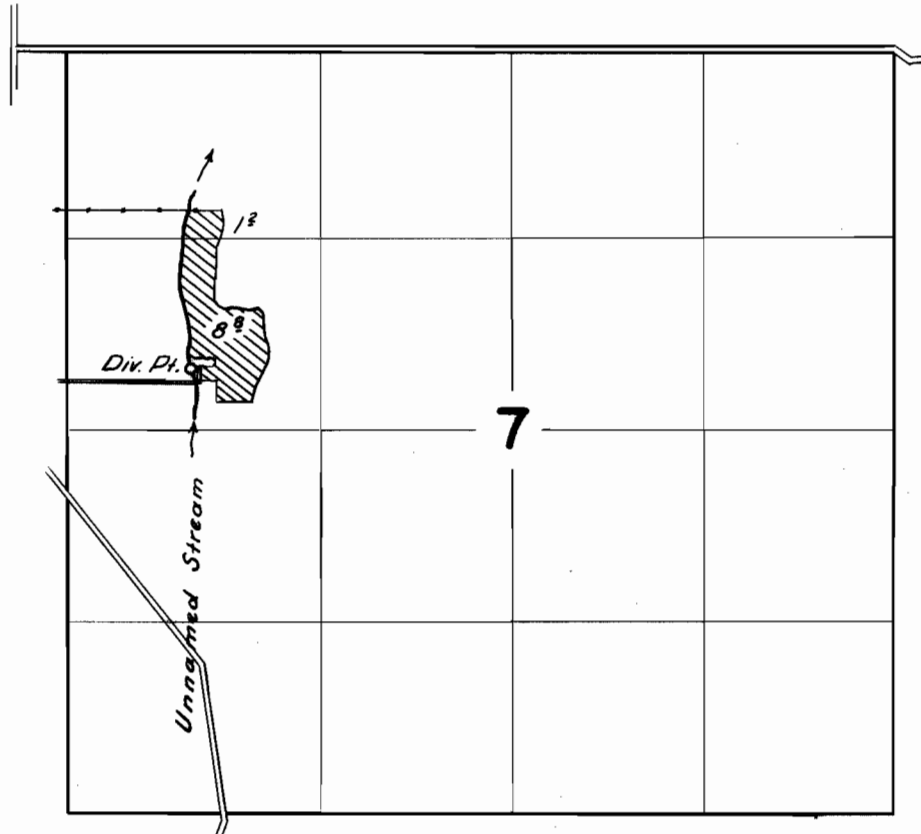

**FINAL PROOF SURVEY**  
UNDER

Application No. 29258 Permit No. 23077  
IN NAME OF

ARLEAN TUCKER

Surveyed 7 May 1957, by [Signature]