


T. 2N. R. 32E. W.M.

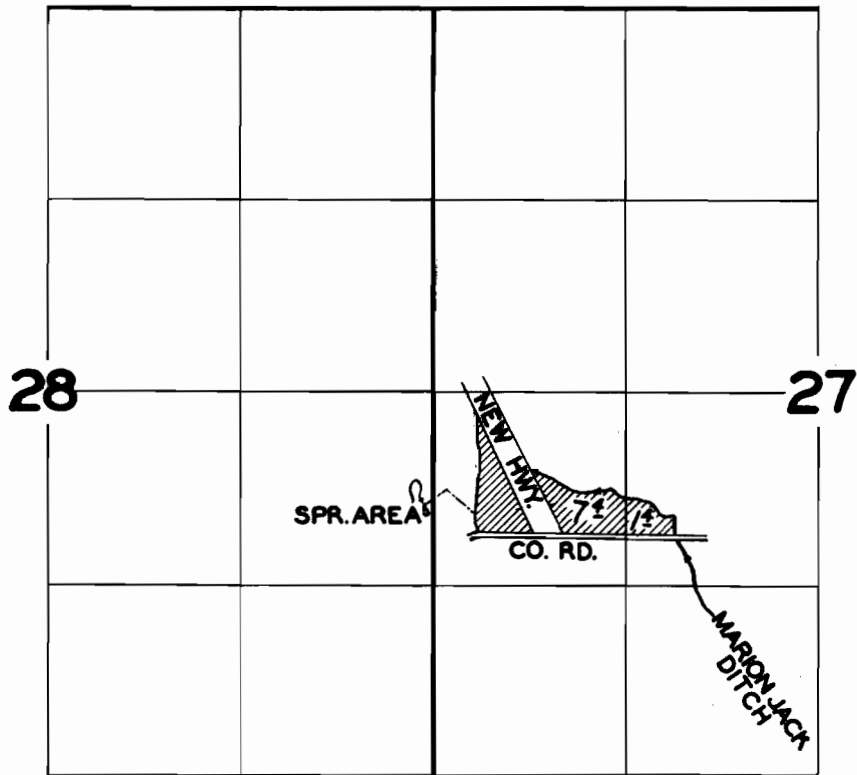

FINAL PROOF SURVEY

UNDER

Application No. 29844 Permit No. 23469

IN NAME OF

ELLIS J. WYLAND

Surveyed MAY 14 1957, by C. O. Smith