


T.17S.R.6W.W.M.

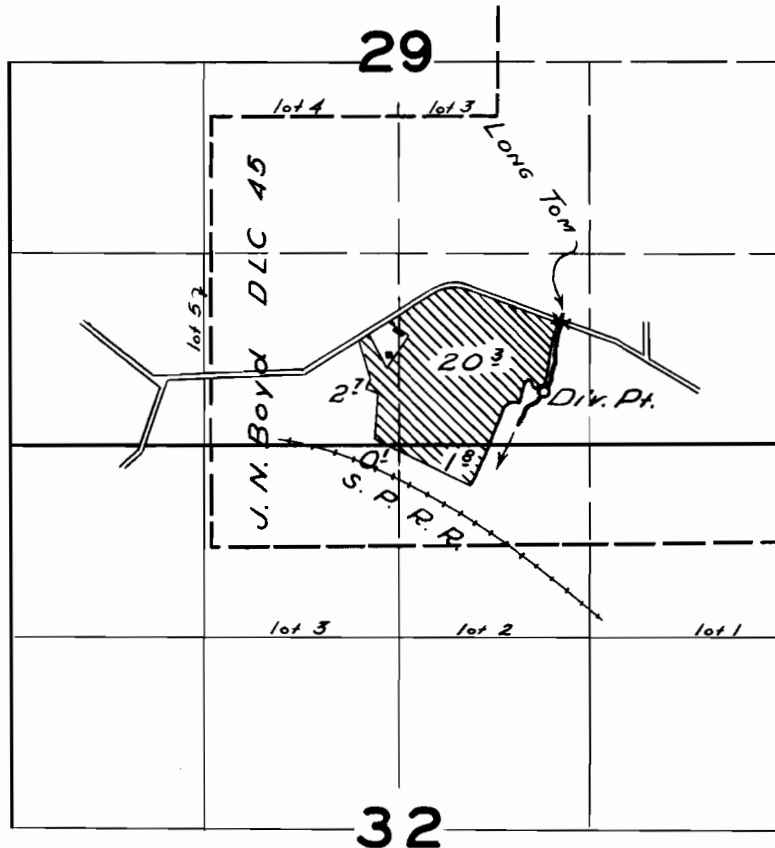

FINAL PROOF SURVEY
UNDER

Application No. 29772 Permit No. 23504
IN NAME OF

CHARLES R. McDANIEL

Surveyed 2 May 1957, by Edw. Kelly