


T.17S.R.5&6W.W.M

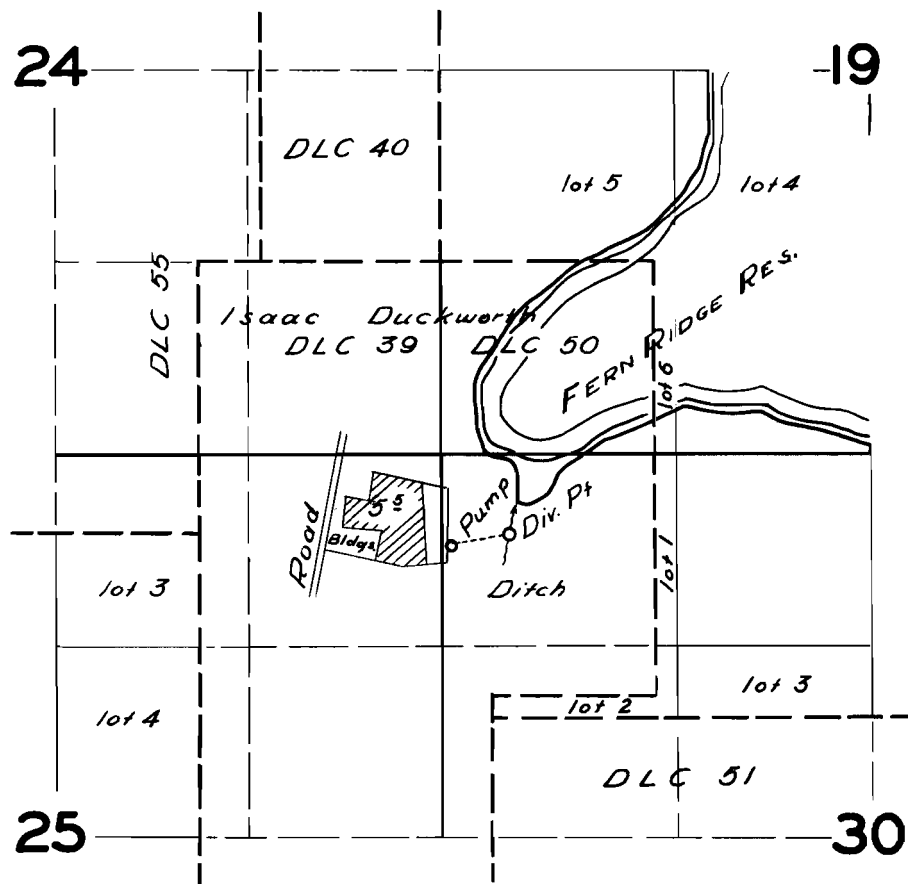

FINAL PROOF SURVEY

UNDER

Application No. 29878 Permit No. 23530

IN NAME OF

ELMIRA UNION HIGH SCHOOL, DIST. U-4

Surveyed 30 Apr. 1957, by *Chas. R. Pitty*