


# T.7S.R.5W.W.M.

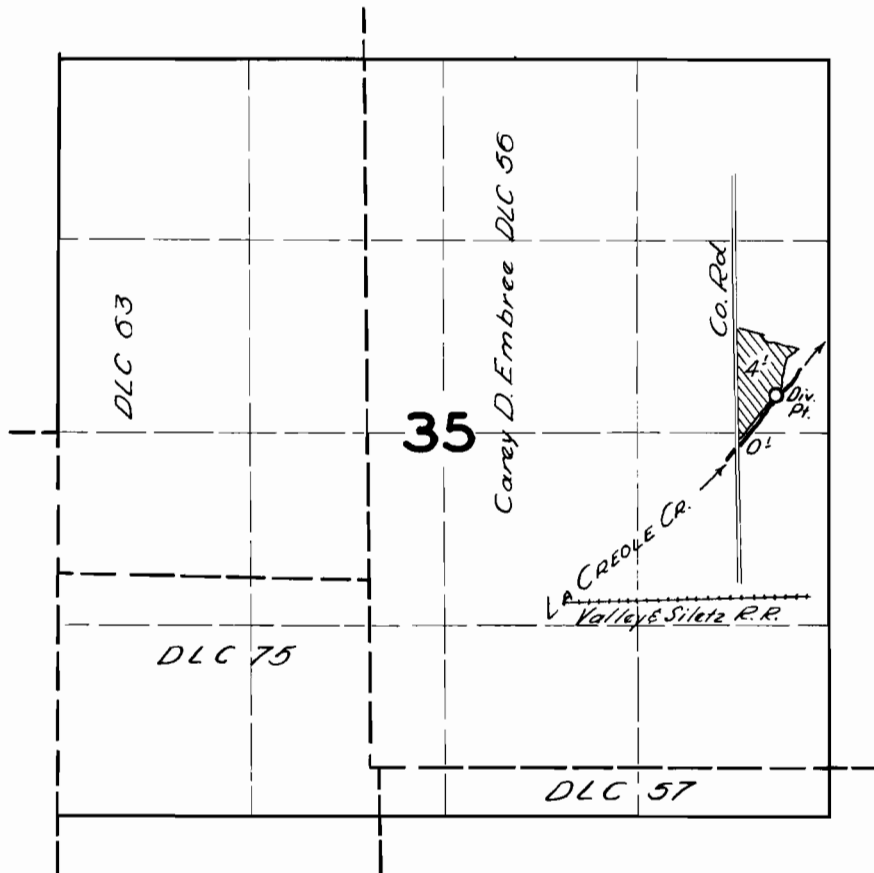

## FINAL PROOF SURVEY UNDER

Application No. 29880 Permit No. 23531  
IN NAME OF

LESLIE WILLIS

Surveyed 5 April 1957, by [Signature]