


T.17S.R.1E.W.M.

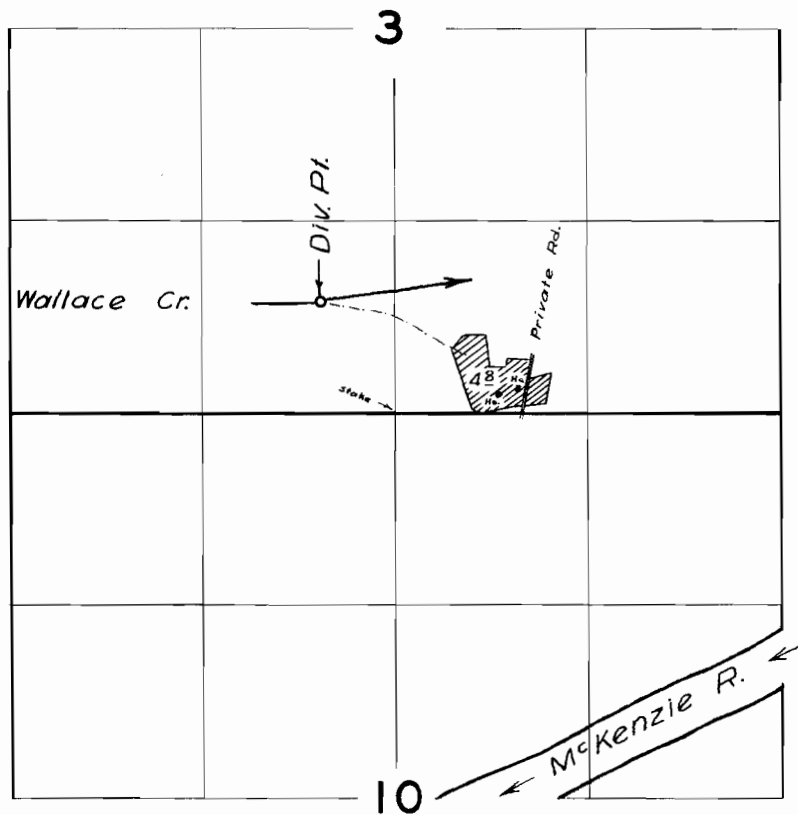

FINAL 10% OF SURVEY  
UNDER

Application No. 29899, Permit No. 23544  
IN NAME OF

Lee C. Barnes

Surveyed June 20 1957, by M. Bish