


T. 4N. R. 4W.W.M.

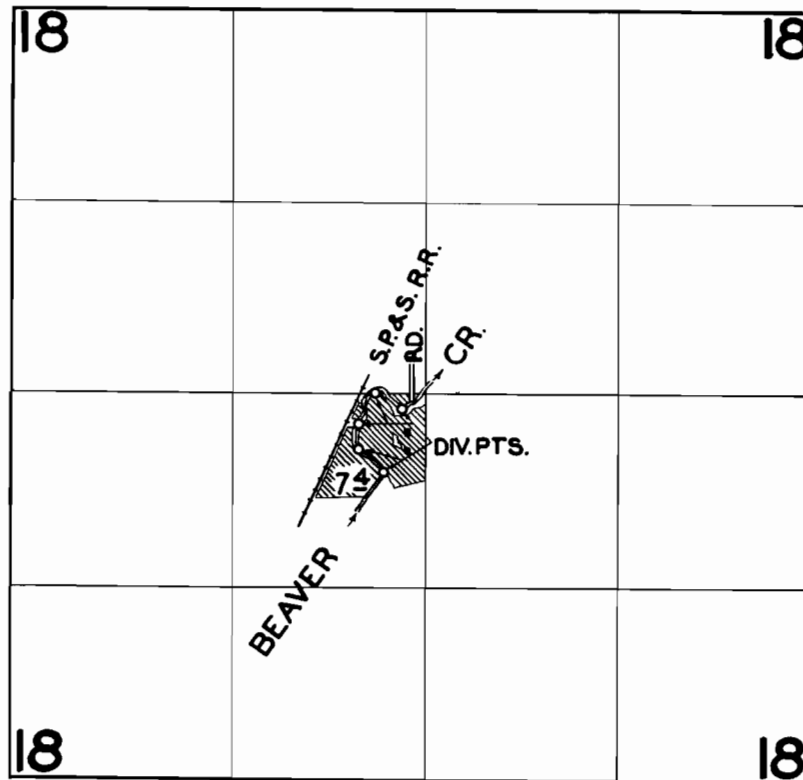

FINAL PROOF SURVEY
UNDER

Application No. 29938 Permit No. 23554
IN NAME OF

WARREN A. & LILLIAN E. CORNOG

Surveyed AUG. 14, 1957, by *[Signature]*