


T.7S.R.1&2W.W.M.

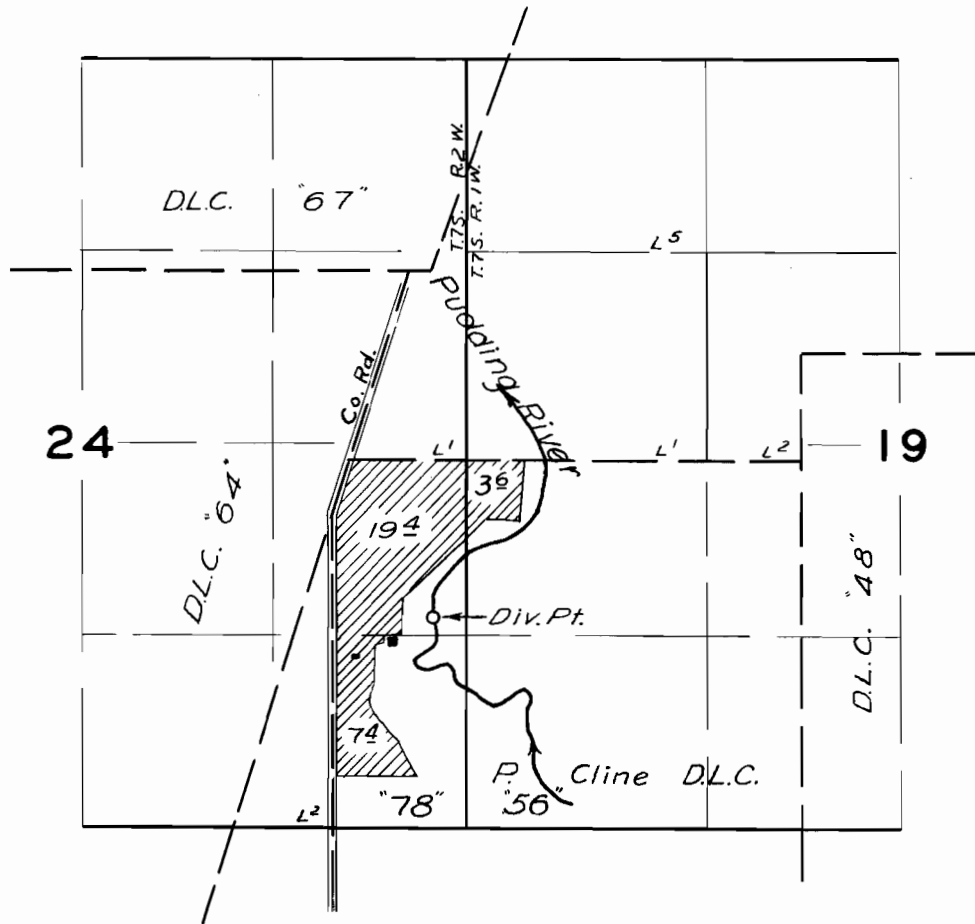

FINAL PROOF SURVEY UNDER

Application No. 30504 Permit No. 23801
IN NAME OF

Leonard D. VanVleck

Surveyed June 13 1957, by M. Bish