


T.13S.R.31E.W.W.

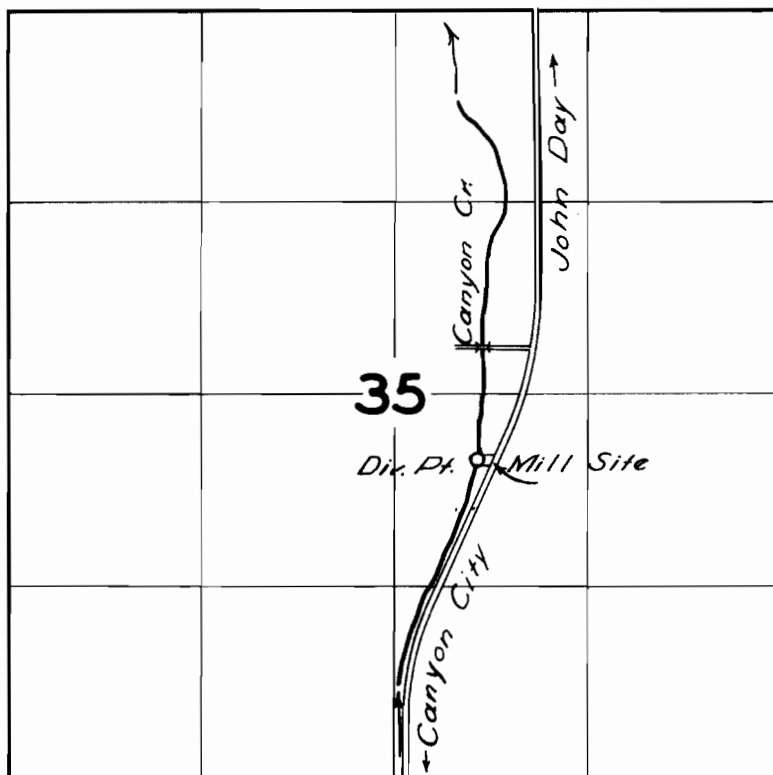

FINAL PROOF SURVEY
UNDER

Application No. 30636 Permit No. 24135
IN NAME OF

ALBERT DUNN

Surveyed 9 July 1957, by [Signature]