


T.18S.R.11W.W.M.

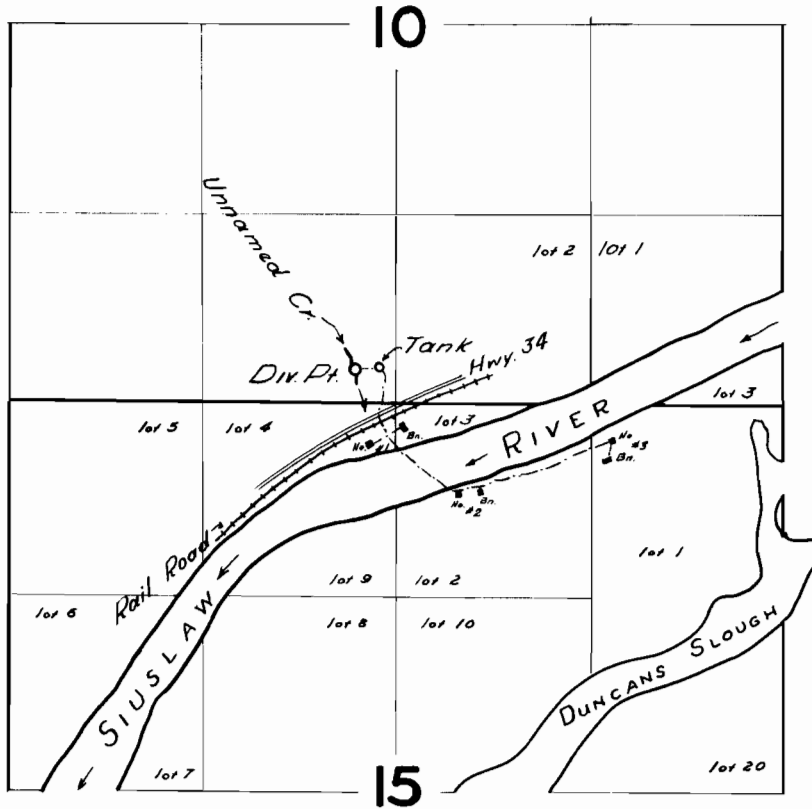

FINAL PROOF SURVEY
UNDER

Application No. 50721 Permit No. 24196
IN NAME OF

EDWARD N. JENSEN

Surveyed 23 May 1957, by *[Signature]*