


T.29S.R.5W.W.M.

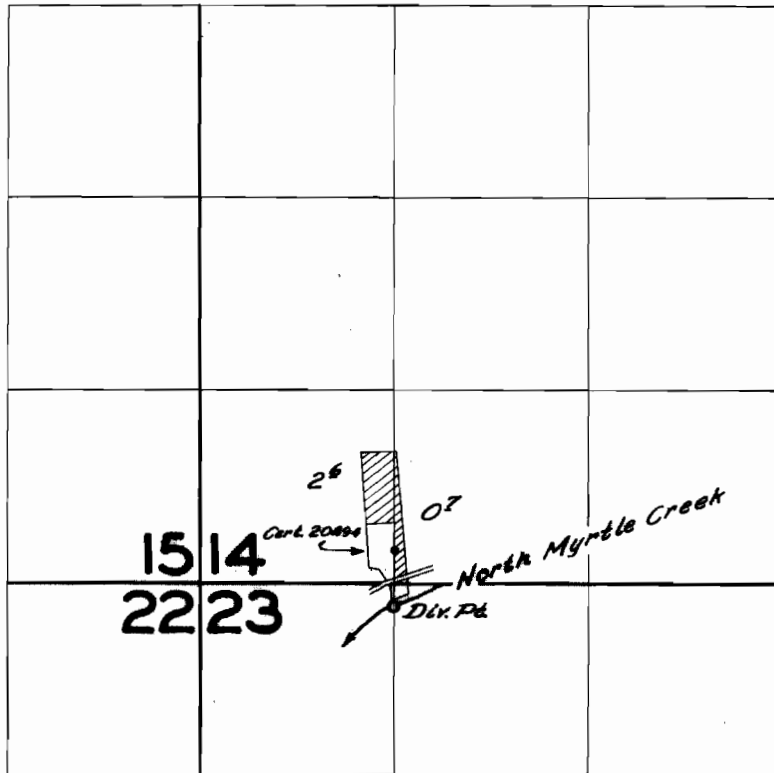

FINAL PROOF SURVEY
UNDER

Application No. *30782* Permit No. *24239*
IN NAME OF

.....*Guy D. Hardage Jr.*.....

Surveyed *June 28* 1957, by *C.O. Bantle*.....