


T.18S.R.11W.W.M.

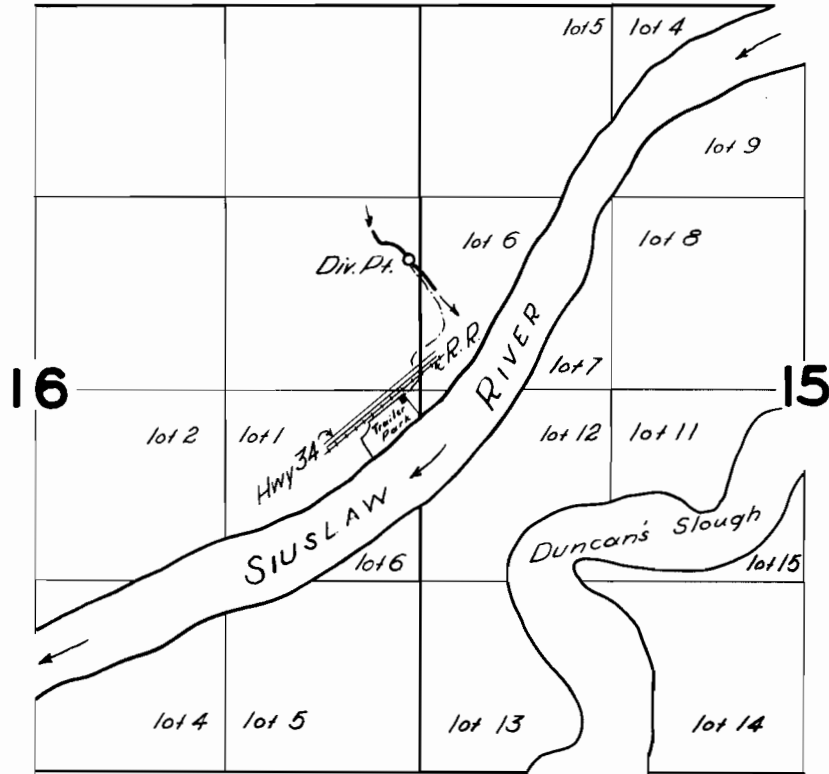

FINAL PROOF SURVEY
UNDER

Application No. 30844 Permit No. 24410
IN NAME OF

EDWIN J. LYONS

Surveyed 23 May 1957, by *[Signature]*