T.9S.R.5W.W.M.

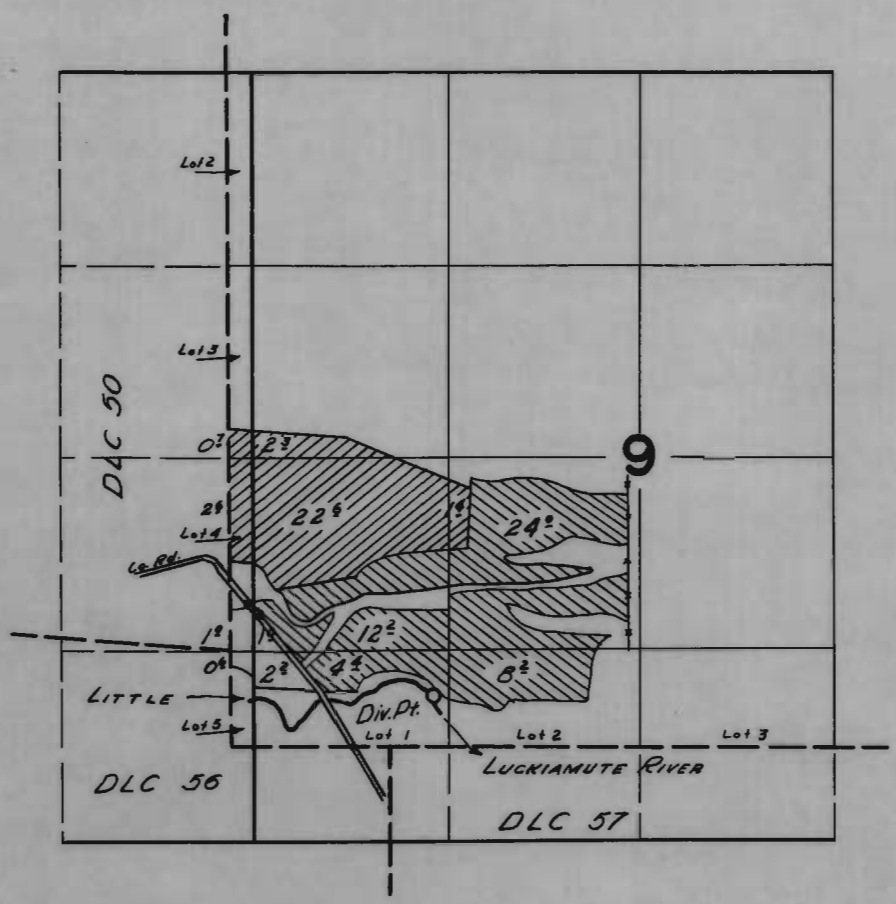

FINAL PROOF SURVEY

UNDER

Application No. 23544 / 31057 Permit No. 18590 / 24422

IN NAME OF

CLARE R. MILLHOUSER

Surveyed 16 Aug 1956 / 27 Mar. 1957, by [signature]

DFP-2D-189