


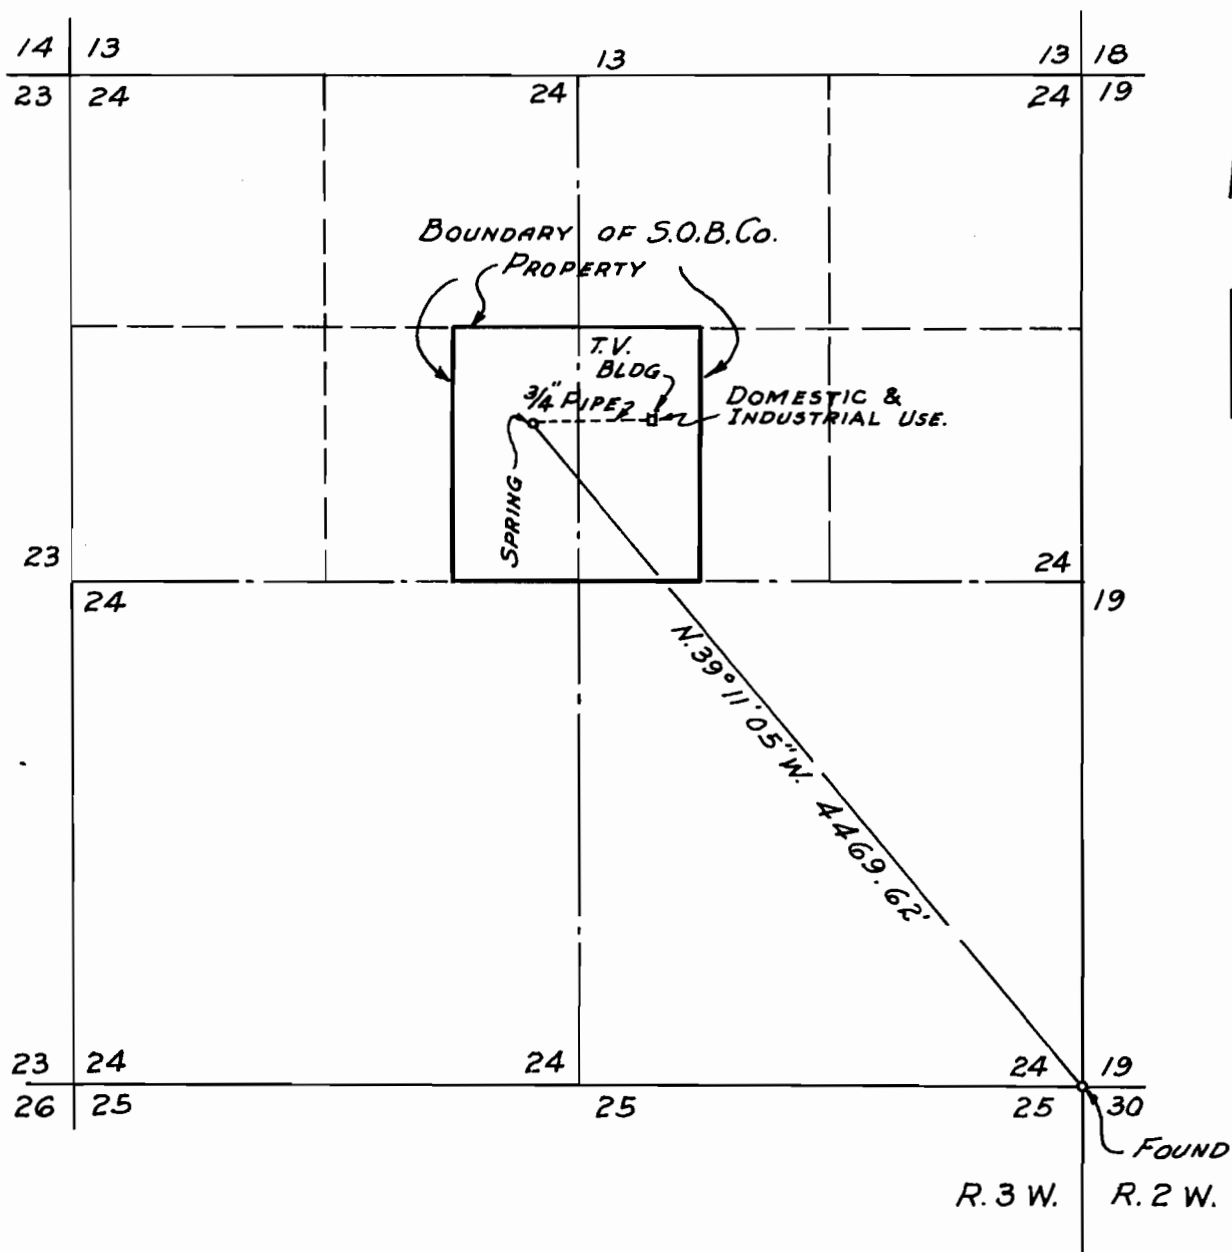

MAP SHOWING LOCATION OF SPRING
IN THE E $\frac{1}{2}$ OF S.E. $\frac{1}{4}$ OF N.W. $\frac{1}{4}$,
SECTION 24, TOWNSHIP 36 SOUTH, RANGE
3 WEST, JACKSON COUNTY, OREGON,
FOR THE USE OF THE SOUTHERN
OREGON BROADCASTING COMPANY.
L.P. LOVEJOY L.S. MEDFORD, ORE.
SCALE:- 1" = 1000' DEC. 19, 1957

Application No. 32039

Permit No. 25271