


T. 6S. R. 2W. W.M.

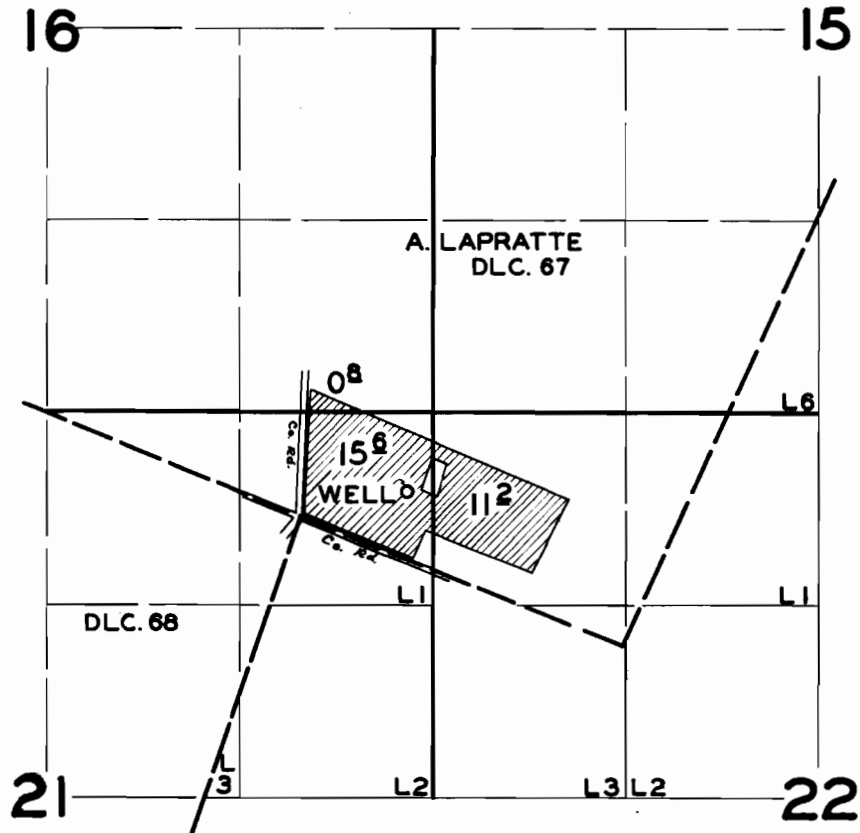

FINAL PROOF SURVEY

UNDER

Application No. G-245 Permit No. G-151

IN NAME OF

CHARLES D. SUMMERS

Surveyed MAR. 22, 1957, by C.O. BARTELS