


T. 5S. R. 1W. W.M.

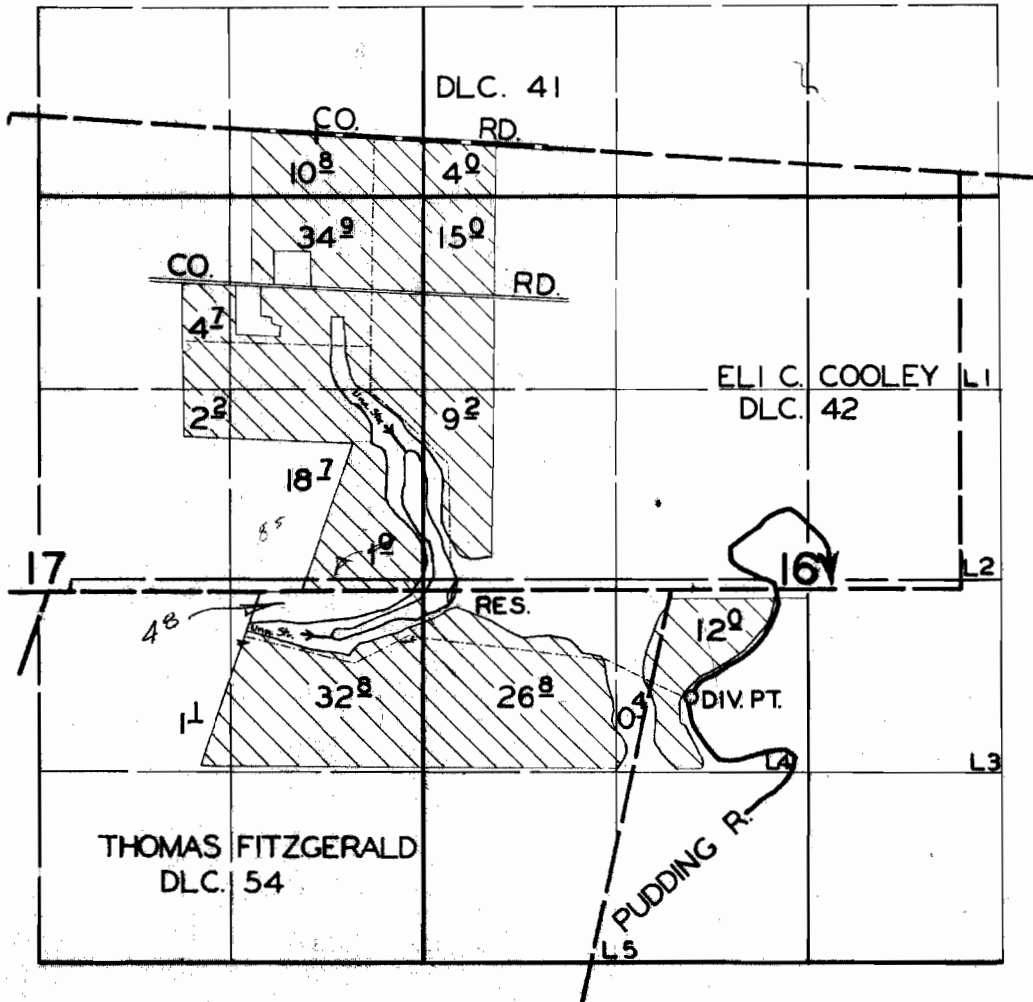

FINAL PROOF SURVEY

UNDER

R-23868

R-1009

Application No. 23869 Permit No. 19180...

IN NAME OF

JOSEPH SERRES

Surveyed 1 MAR 1956, by R.D. BEST