


T.2S.R.4E.W.W.

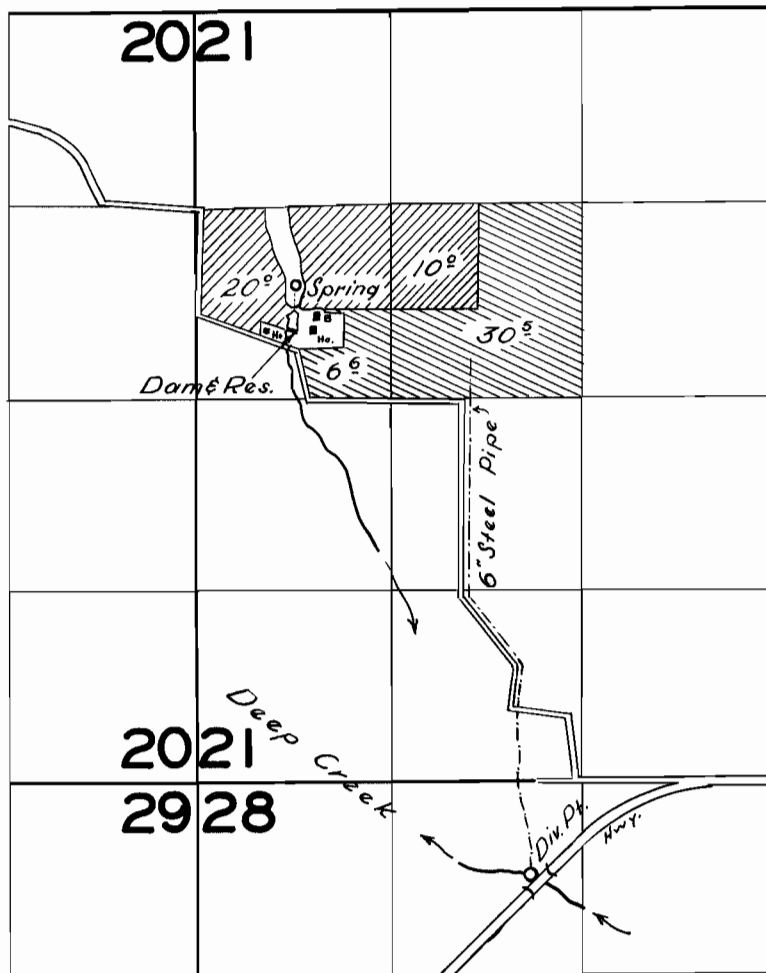

FINAL PROOF SURVEY

UNDER

23140	18233
25284	20503
R-25283	R-1195

Application No. 26930 Permit No. 21651

IN NAME OF

SHIGENARI NAGAE
NAGAE BROS.

Surveyed 22 June 1956, by E. H. Kelly