


T.2S.R.4E.W.W.

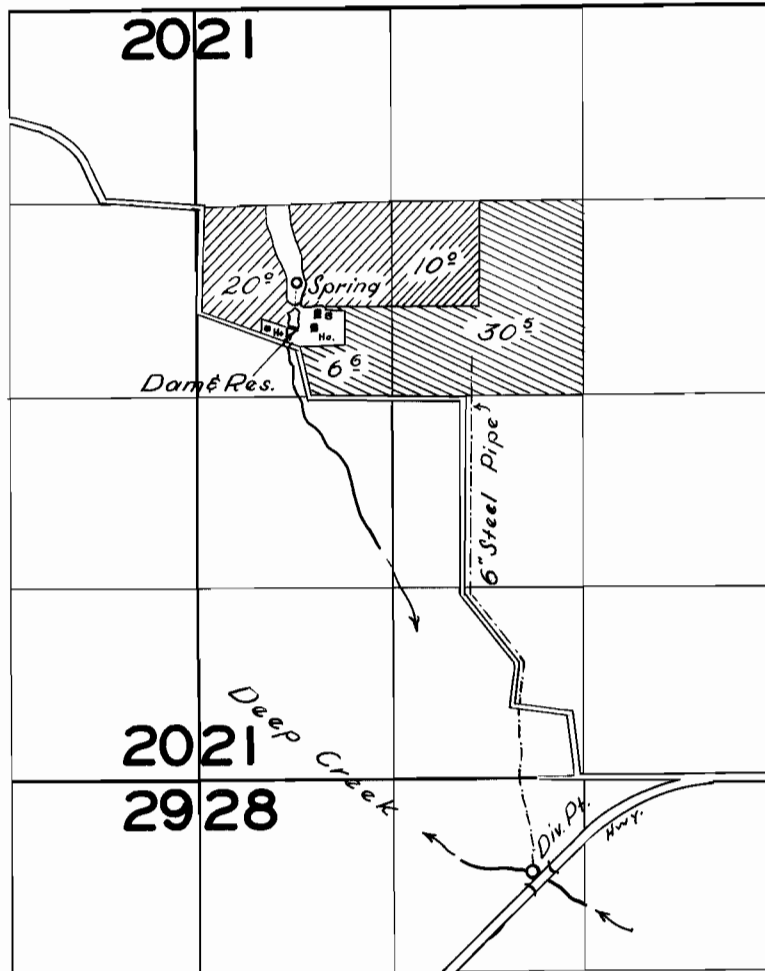

FINAL PROOF SURVEY

UNDER

23140

18233

25284

20503

R-25283

R-1195

Application No. 26930 Permit No. 21651

IN NAME OF

SHIGENARI NAGAE

NAGAE BROS.

Surveyed 22 June 1956, by *W. H. Kelly*