


T.2S.R.4E.W.W.

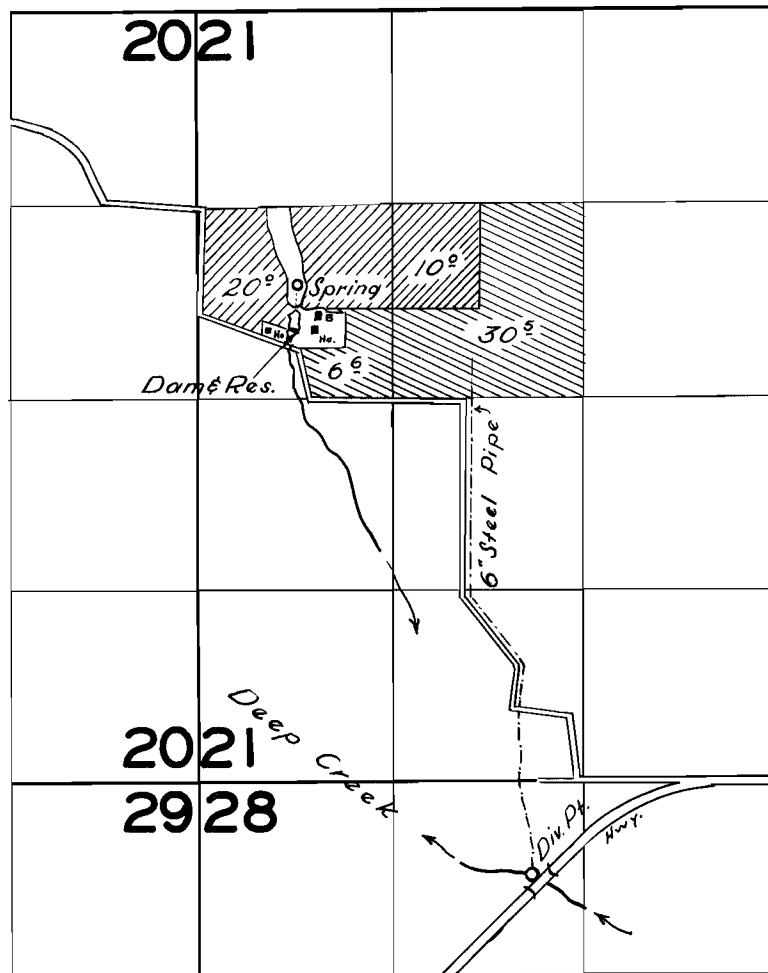

FINAL PROOF SURVEY
UNDER

23140 18233
25284 20503
R-25283 R-1195

Application No. 26930 Permit No. 21651

IN NAME OF
SHIGENARI NAGAE
NAGAE BROS.

Surveyed 22 June 1956, by *E. H. Kelly*