


T.5S.R.11W.W.M.

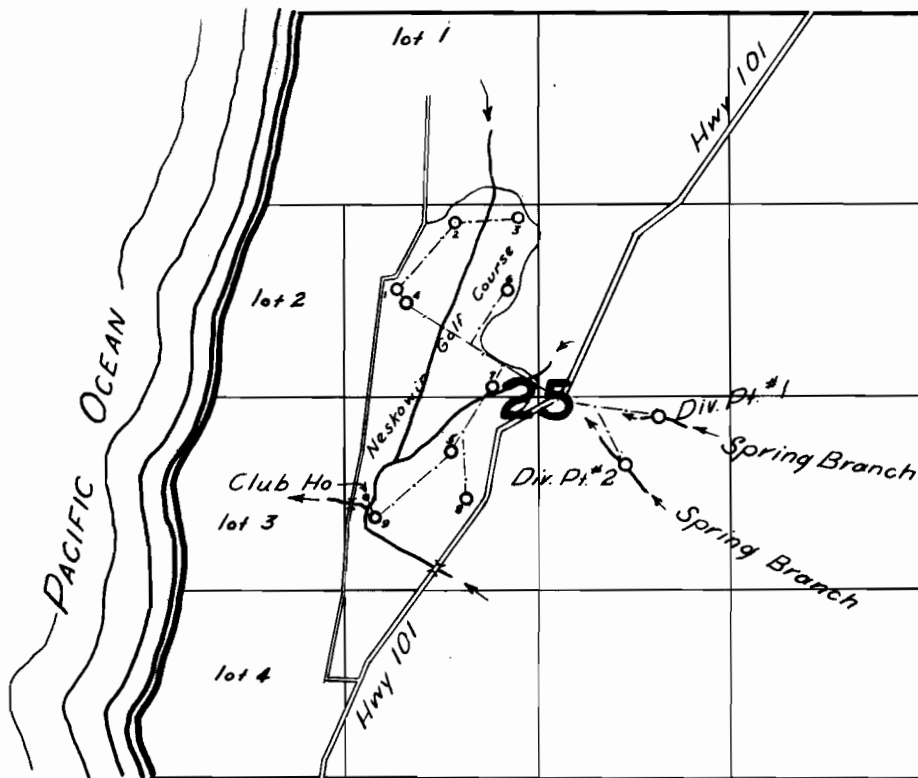

**FINAL PROOF SURVEY**  
UNDER

Application No. 14980 Permit No. 11157  
IN NAME OF

W. S. WALTON

Surveyed 7 Aug 1957, by [Signature]