


11625
24384

T. 8S. R. 32&33E. WM.

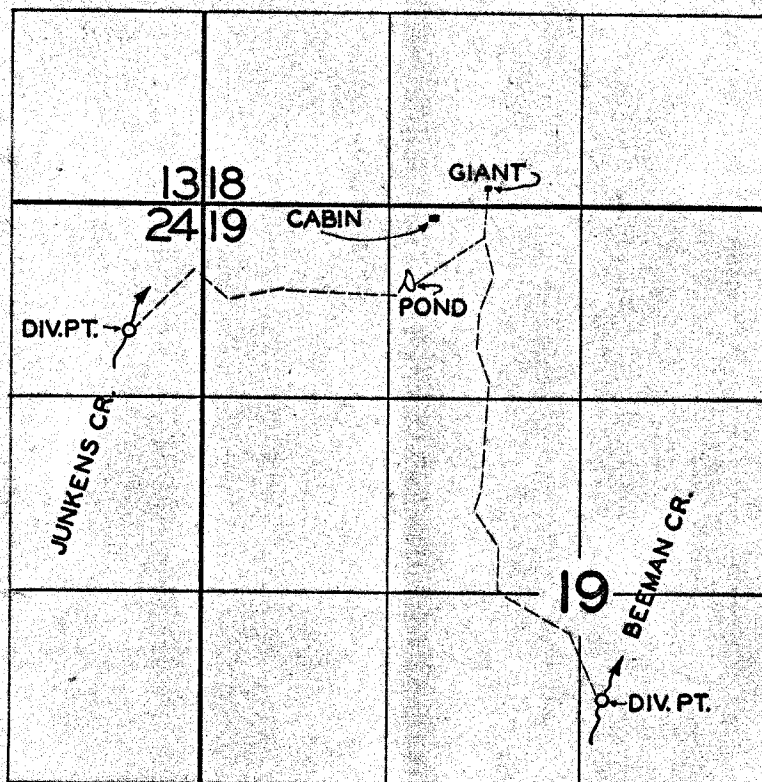

FINAL PROOF SURVEY
UNDER

Application No. 15686.. Permit No. 11625..
IN NAME OF

W. G. KEENEY

Surveyed JULY 14... 1957., by

1957 M