


T.20S.R.4W.W.M.

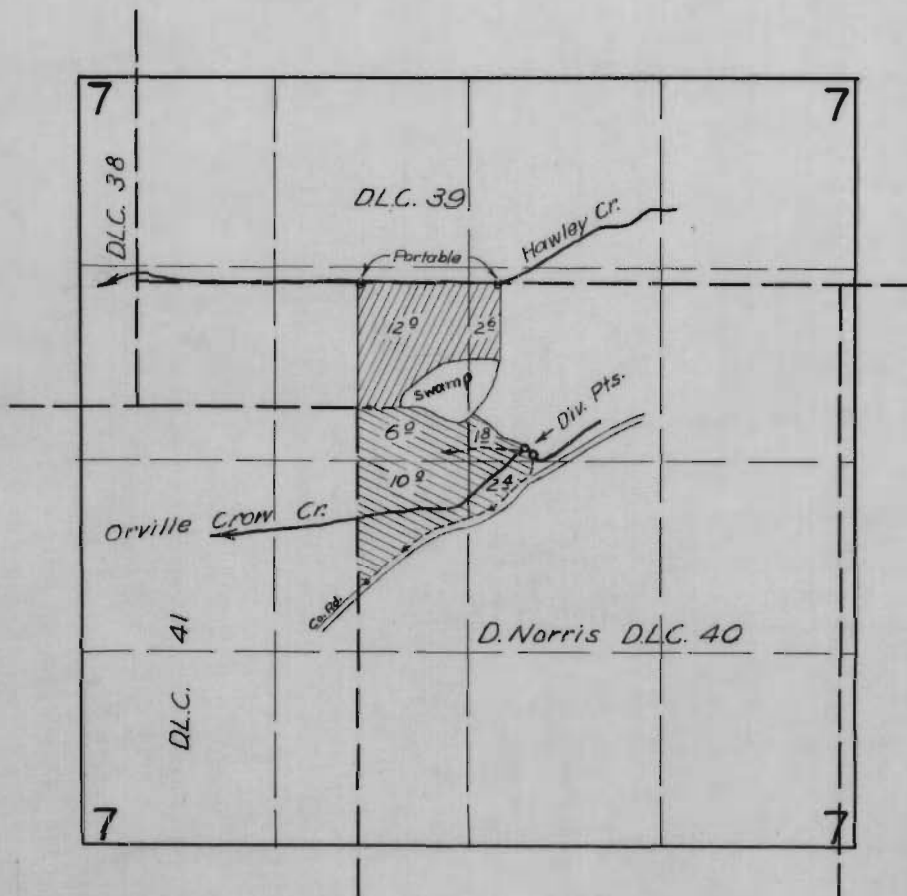

FINAL PROOF SURVEY
UNDER

Application No. 17165 Permit No. 12882
IN NAME OF

Purdy & Sons

Surveyed April 25 1957, by M. Beah