


T.16S.R.7W.W.M.

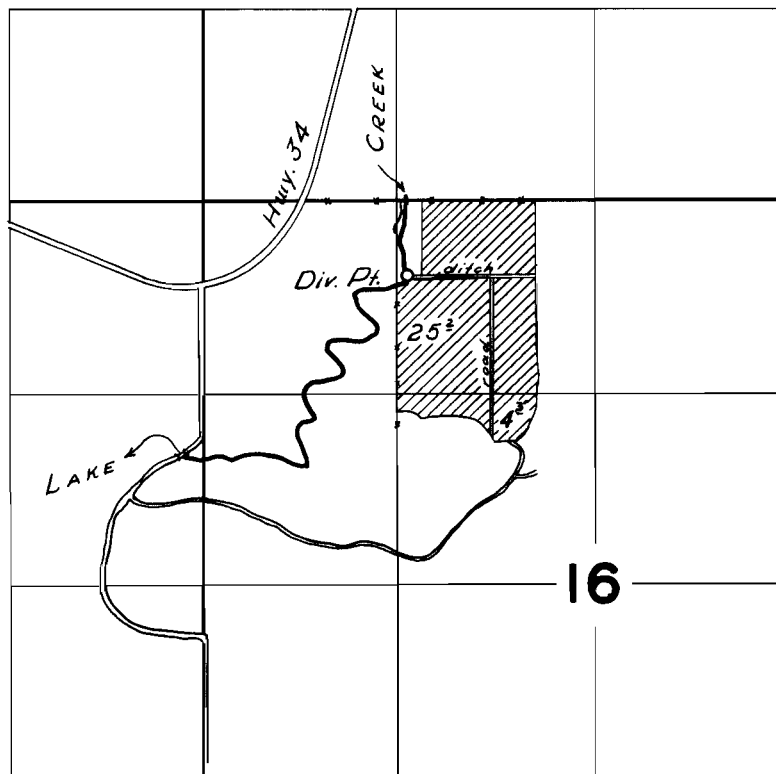

FINAL PROOF SURVEY
UNDER

Application No. 17511 Permit No. 13216

IN NAME OF

F. L. NORTON

Surveyed 16 May 1957, by [Signature]