


T. 4N. R. 9W. W.M.

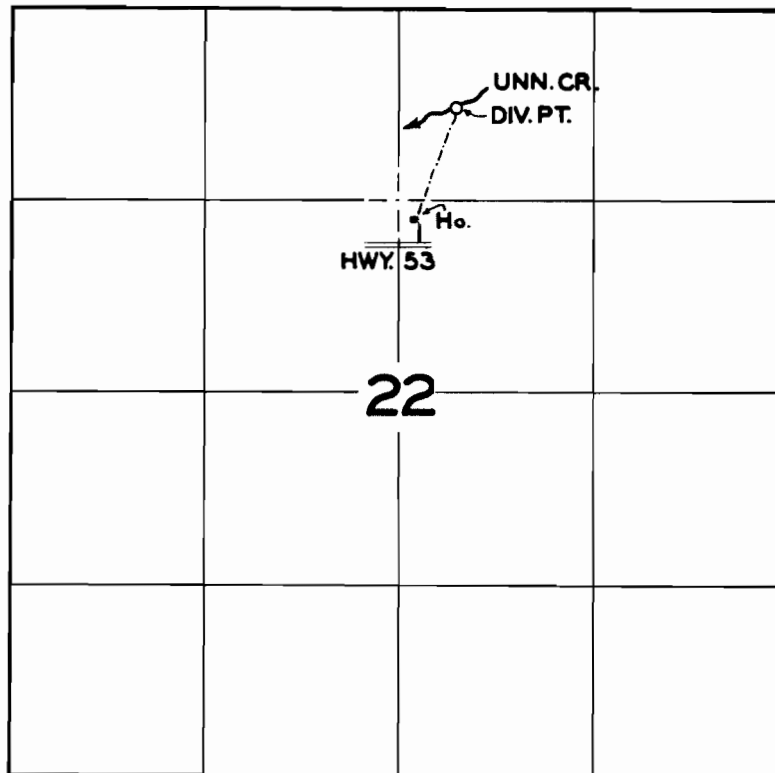

**FINAL PROOF SURVEY**  
UNDER

Application No. 17807 Permit No. 13498  
IN NAME OF

Surveyed AUG. 13 1957, by *Arthur J. Kelly*