


T.17S.R.6W.W.M.

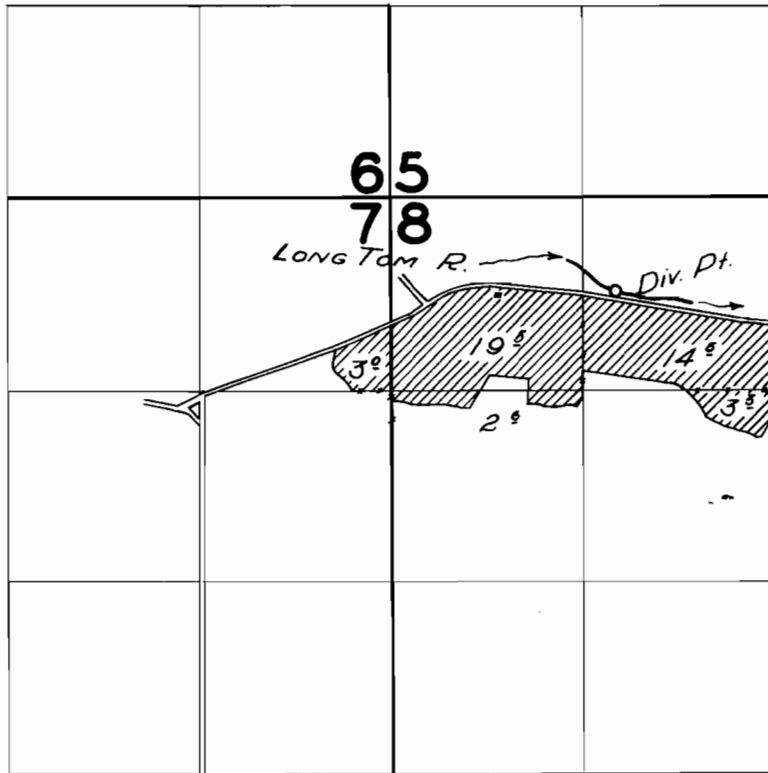

**FINAL PROOF SURVEY**  
UNDER

Application No. 19684 Permit No. 15263

IN NAME OF

W. C. VARNER

Surveyed 1 May 1957, by [Signature]