


T.18S. R.19E.W.M.

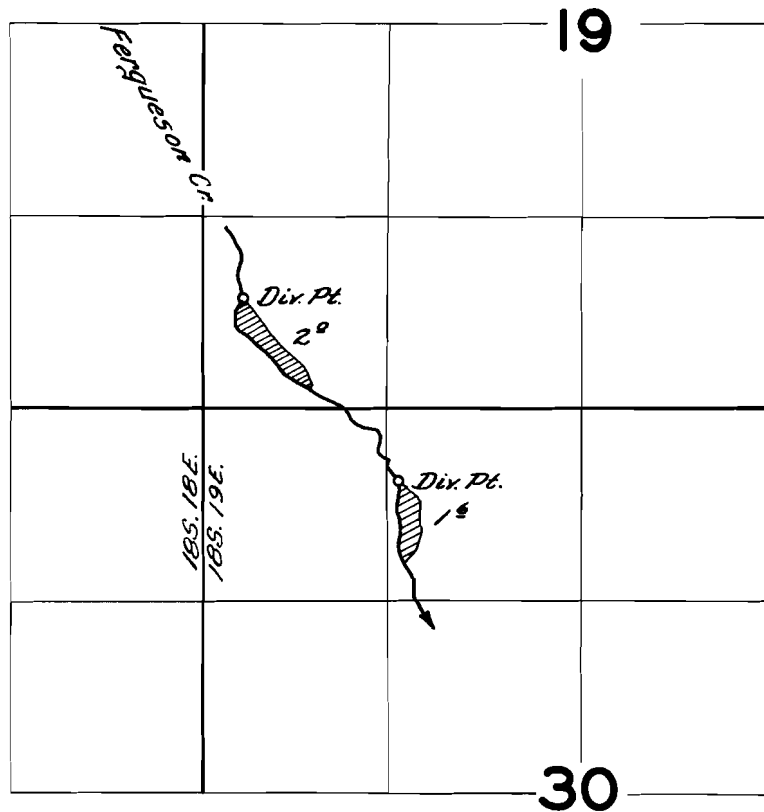

FINAL PROOF SURVEY
UNDER

Application No. 20097 Permit No. 15682
IN NAME OF

Sumner W. Houston

Surveyed Sept. 27 1957, by C.D. Smith