


T. 3 S. R. 3 W. W. M.

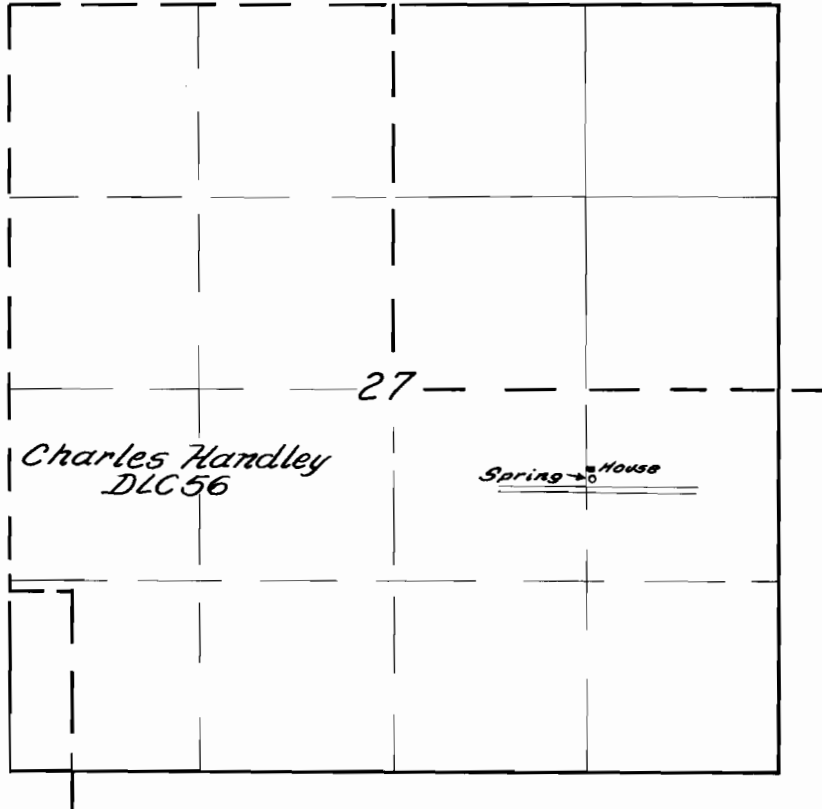

FINAL PROOF SURVEY
UNDER

Application No. 20322 . . . Permit No. 15853 . . .
IN NAME OF

David & Lillian Wainer

Surveyed *May 15* 1958, by *M. Bisk*