


T.16S.R.5W.W.M.

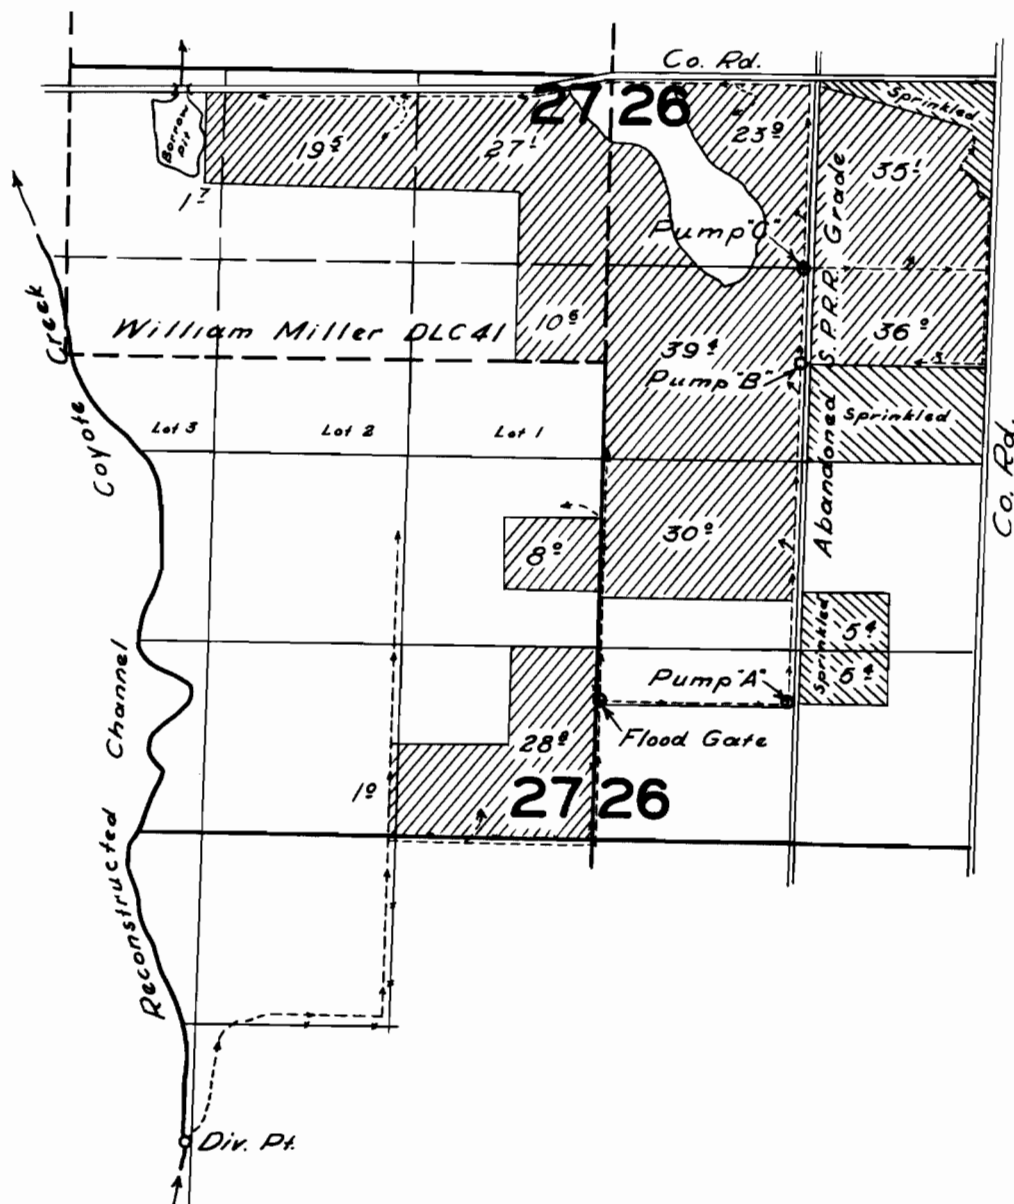

FINAL PROOF SURVEY
UNDER

Application No. 20436 Permit No. 15956
IN NAME OF

ASH BAILEY

Surveyed 20 May 1957, by [Signature]