


# T. 1 S. R. 10 E. W. M.

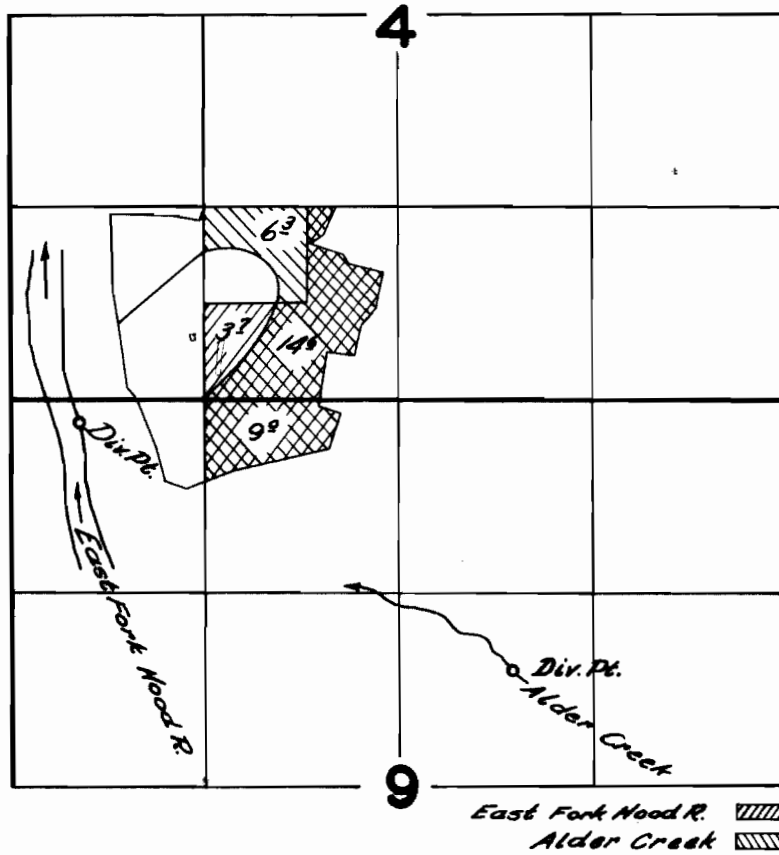

## FINAL PROOF SURVEY

UNDER

Application No. 25961.. Permit No. 21508..

IN NAME OF

*Berta Klausner Goetz & Edward Goetz*

Surveyed *April 24 1957*, by *C.O. Bartels*