


T. 3S. R. 9W. W.M.

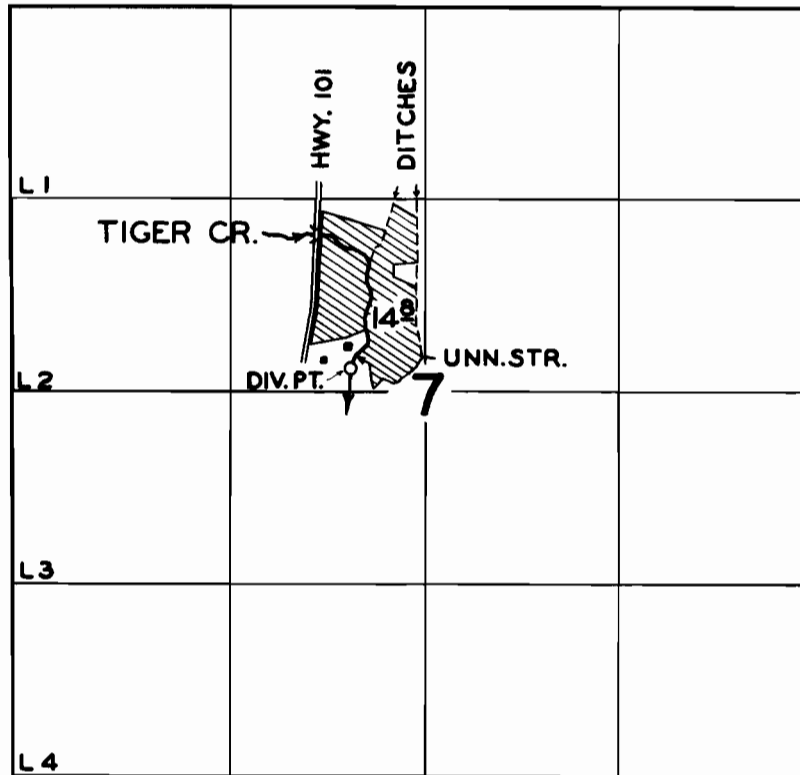

FINAL PROOF SURVEY
UNDER

Application No. 20759 Permit No. 16244
IN NAME OF

Surveyed AUG.27 1957, by *[Signature]*