


T.6S.R.10W.W.M.

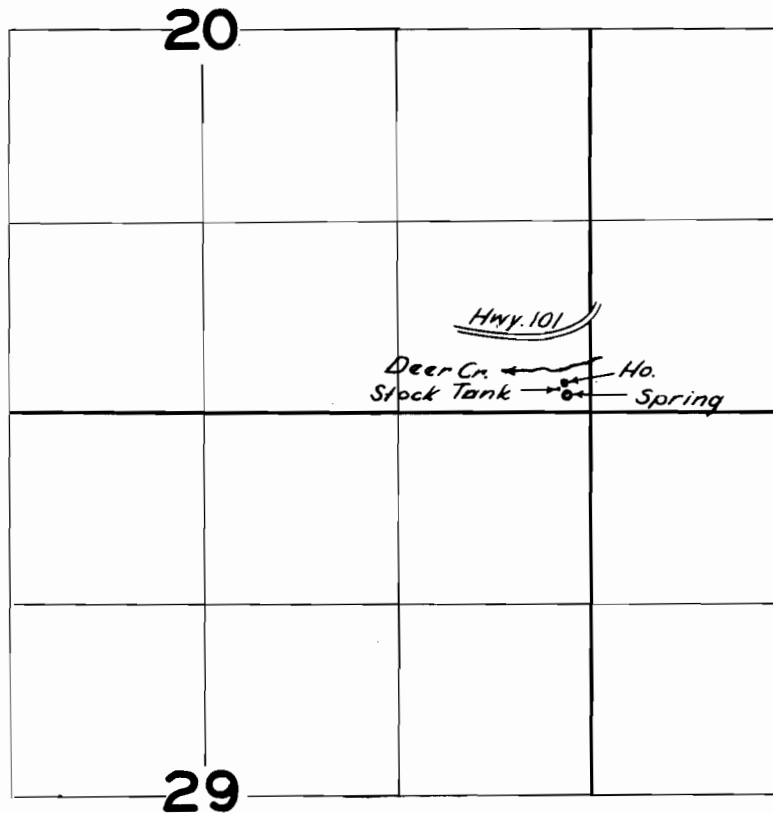

FINAL PROOF SURVEY

UNDER

Application No. 21050 Permit No. 16495

IN NAME OF

MIKE SCHROEDER

Surveyed 6 Aug 1957, by R. A. Kelly