


T.18S. R.11W. W.M.

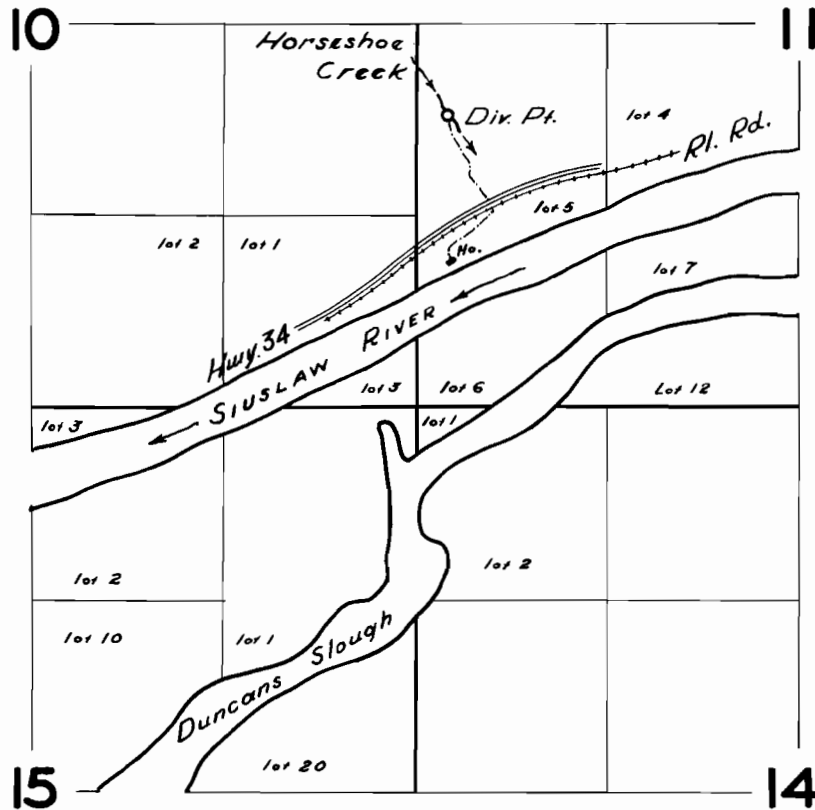

FINAL PROOF SURVEY
UNDER

Application No. 21435 Permit No. 16816
IN NAME OF

RALPH R. WOLF

Surveyed 23 May 1957, by [Signature]