


T. 4N. R. 10W. W.M.

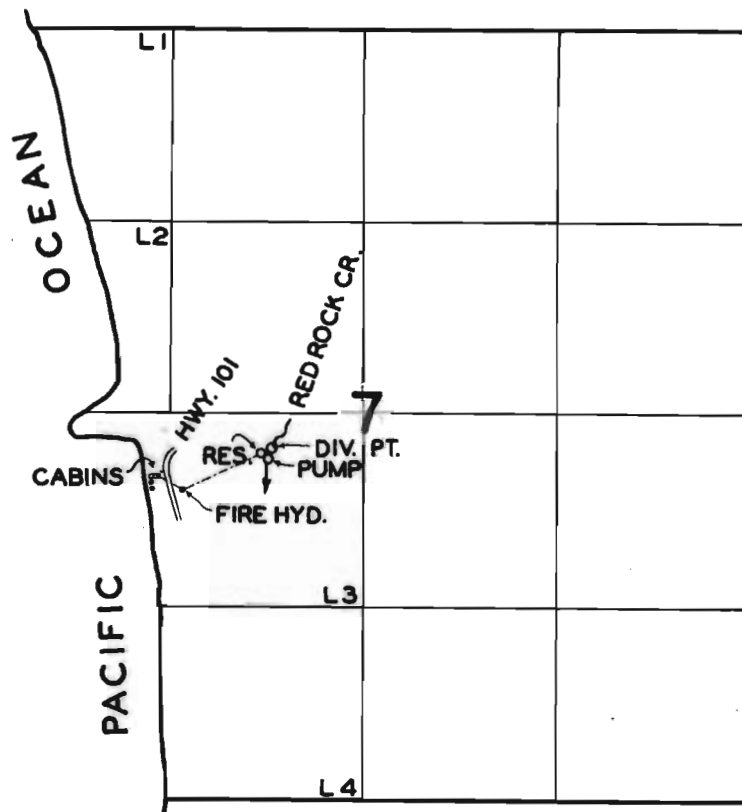

FINAL PROOF SURVEY
UNDER

Application No. 21512 Permit No. 16932
IN NAME OF

F. G. TINSMAN

Surveyed AUG. 12. 1957. by *[Signature]*