


T.16S.R.5E.W.M.

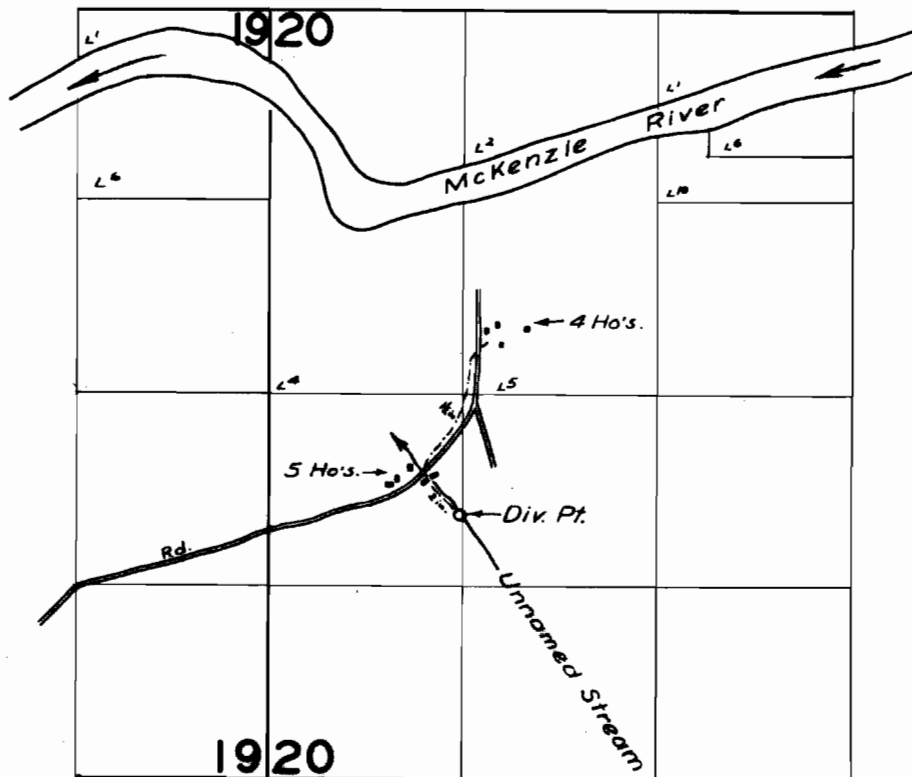

FINAL PROOF SURVEY

UNDER

Application No. 21692 Permit No. 17035
IN NAME OF

Clarence R. and Martha A. Belknap

Surveyed June 26, 1957, by M. Bish