


T.13S.R.5W.W.M.

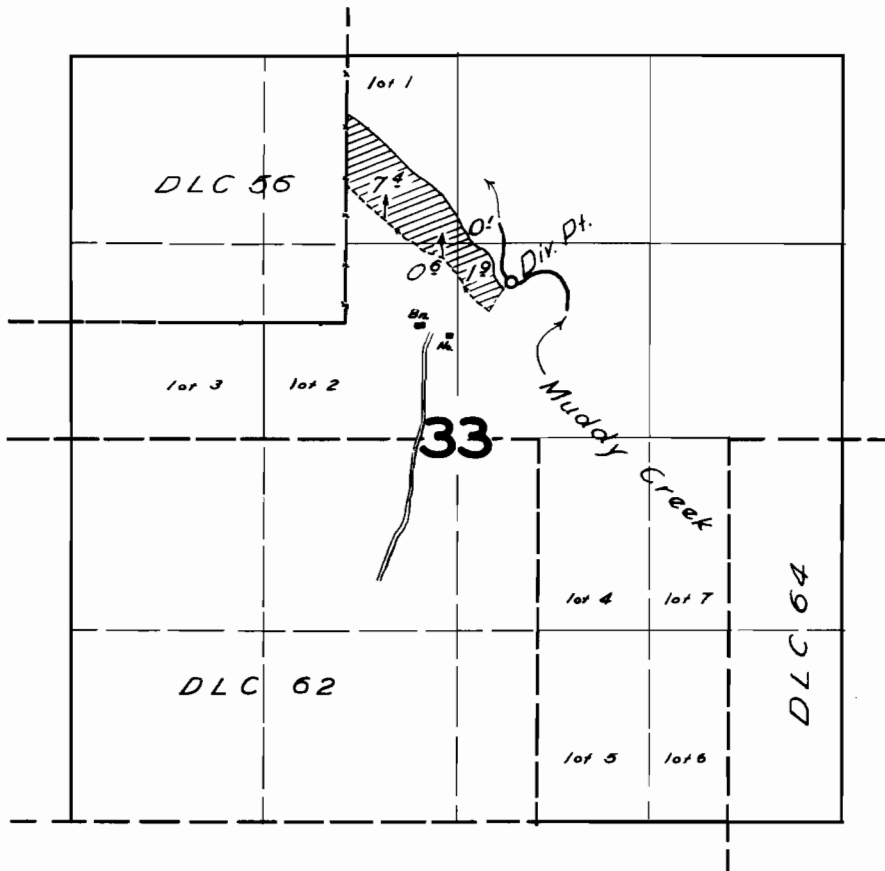

FINAL PROOF SURVEY
UNDER

Application No. 21831 Permit No. 17171
IN NAME OF

R. F. CHEADLE

Surveyed 22 Aug 1957, by [Signature]