


T.16 S.R.4 E.W.M.

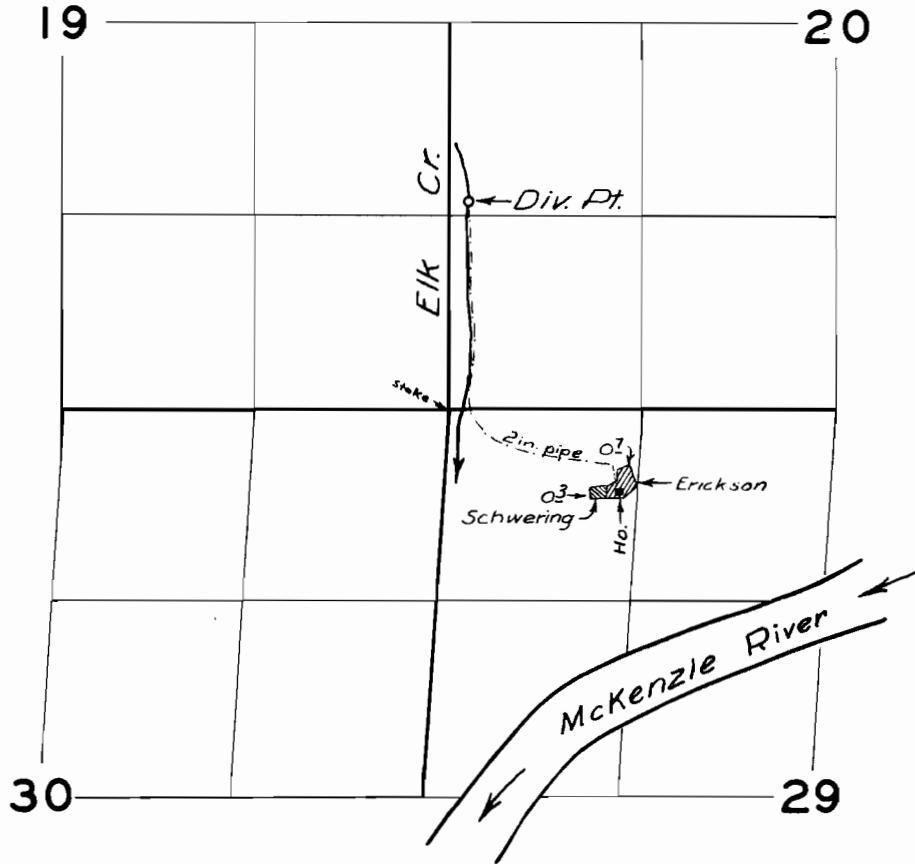

FINAL PROOF SURVEY
UNDER

Application No. 22891 Permit No. 18056
IN NAME OF

W.E. Schwering & Carl F. Erickson

Surveyed July 1, 1957, by Tm. Bish