


T.16 S.R.4 E.W.M.

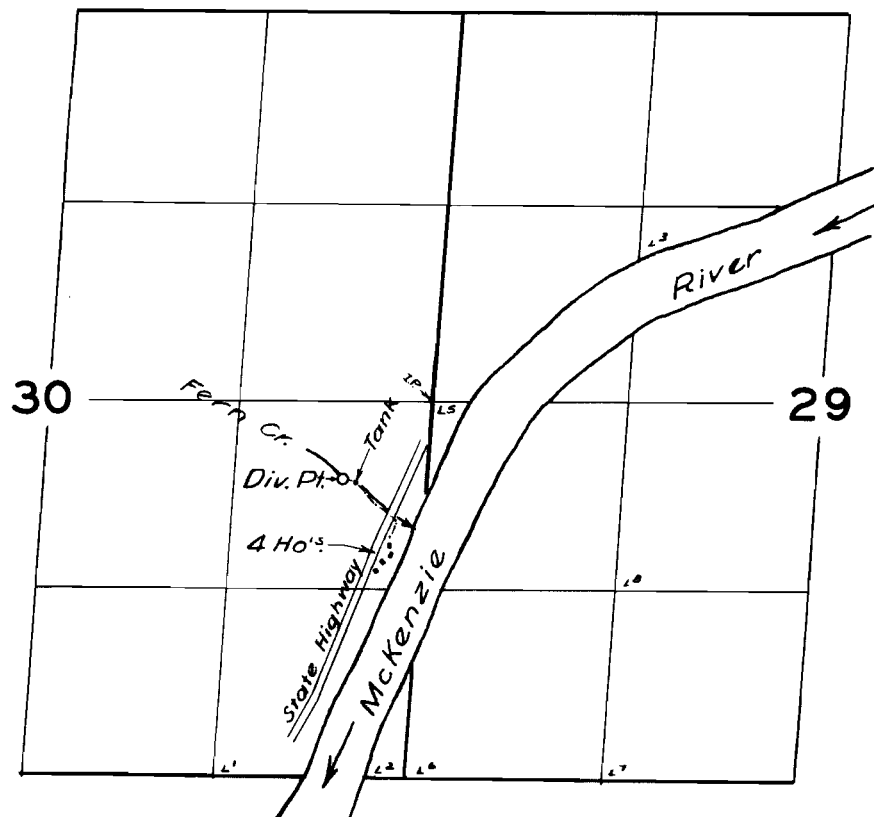

FINAL PROOF SURVEY
UNDER

Application No. 23247 Permit No. 18555
IN NAME OF

Ernest A. Smith

Surveyed June 28 1957, by M. Bish