


# T27SR5WWM

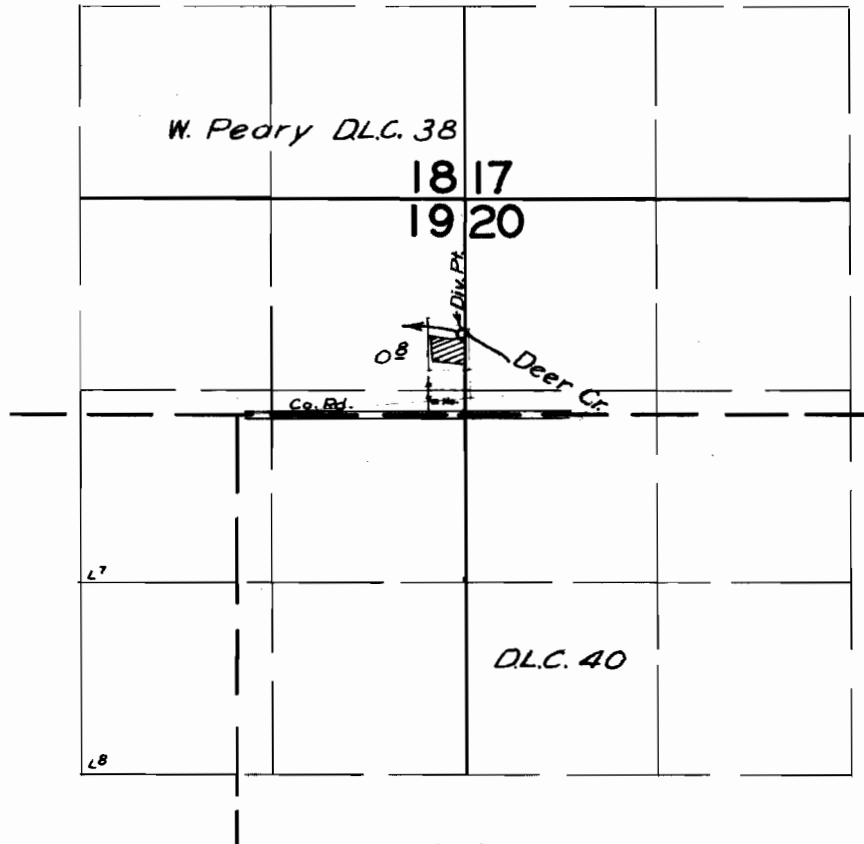

## FINAL PROOF SURVEY UNDER

Application No. 23820 Permit No. 18819  
IN NAME OF

B.C. Germod

Surveyed July 15 1957, by Tr. Bieh