


T.14S.R.5W.W.M.

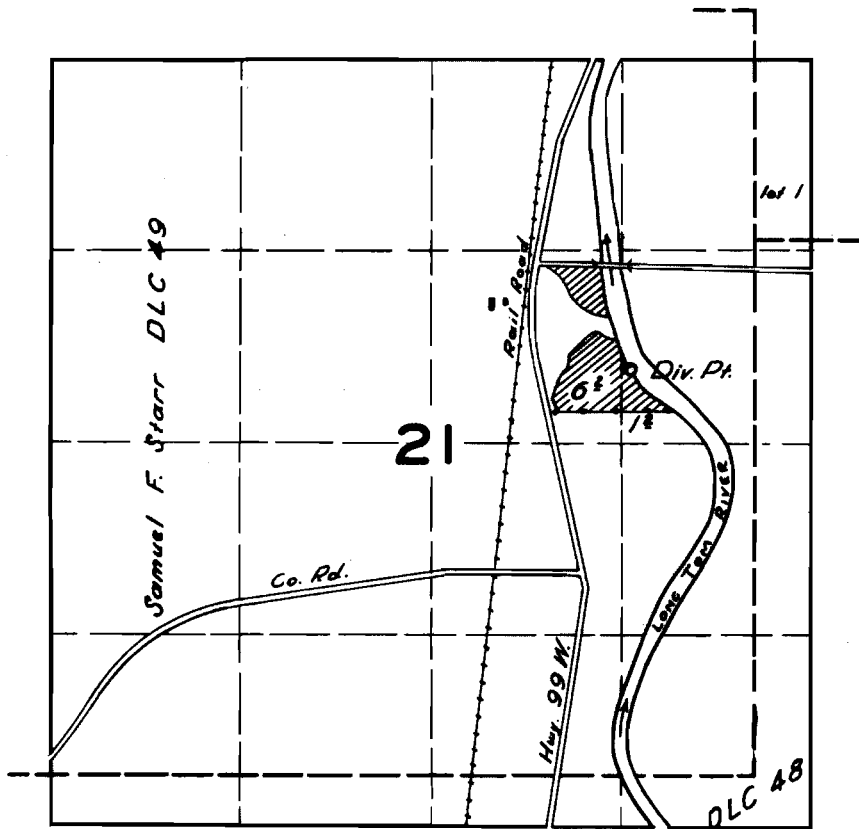

FINAL PROOF SURVEY

UNDER

Application No. 23888 Permit No. 18830

IN NAME OF

EDWARD & ANNIE M. REX

Surveyed 26 Apr. 1957, by [Signature]