


T.12S.R.6W.W.M.

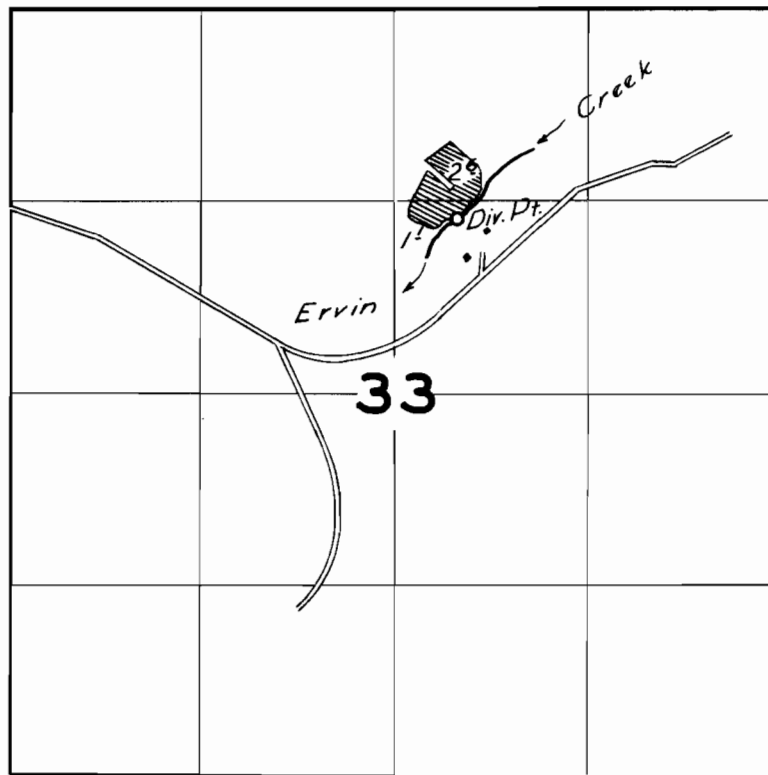

FINAL PROOF SURVEY
UNDER

Application No. 24028 Permit No. 18943
IN NAME OF

ROY & JESSE ERVIN

Surveyed 21 Aug. 1957, by *[Signature]*