


T.22 S.R.4 W.W.M

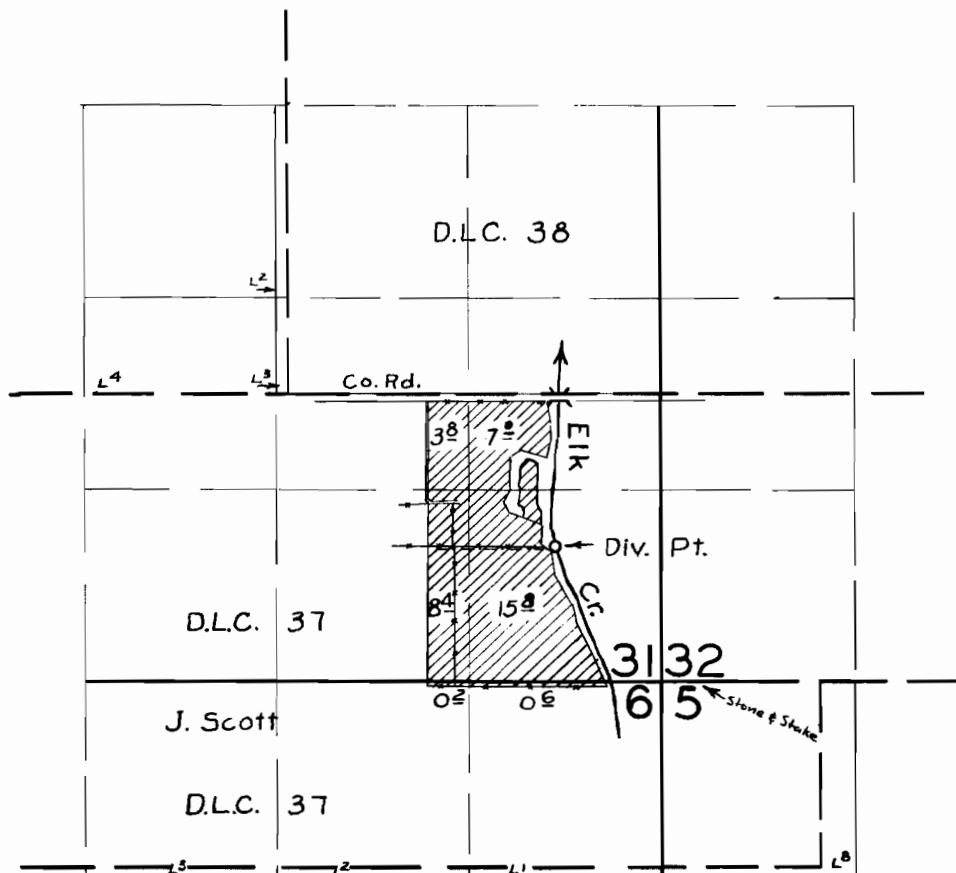

FINAL PROOF SURVEY UNDER

Application No. 24293 Permit No. 19122
IN NAME OF

Fred Booth & Dan R. Russell

Surveyed 12 Sept. 1957, by M. Bish