


T. 7S. R. 5W. W.M.

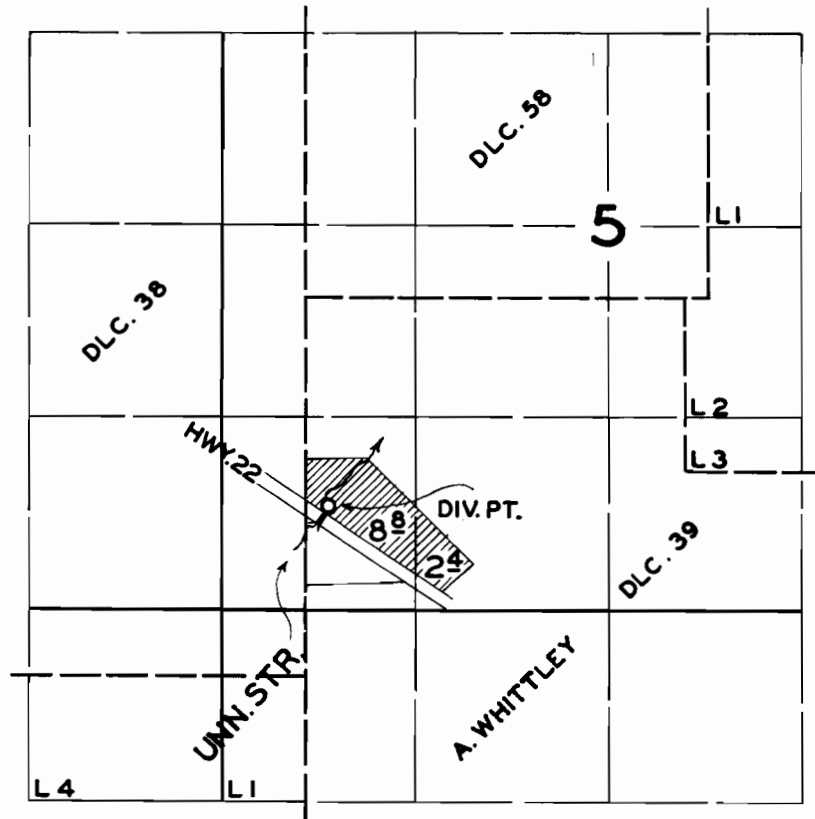

FINAL PROOF SURVEY
UNDER

Application No. 24345 Permit No. 19226
IN NAME OF

CLIFFORD D. BRITTON

Surveyed JULY 25, 1957, by *Ed Whittley*