


T. 29S. R. 5W. W.M.

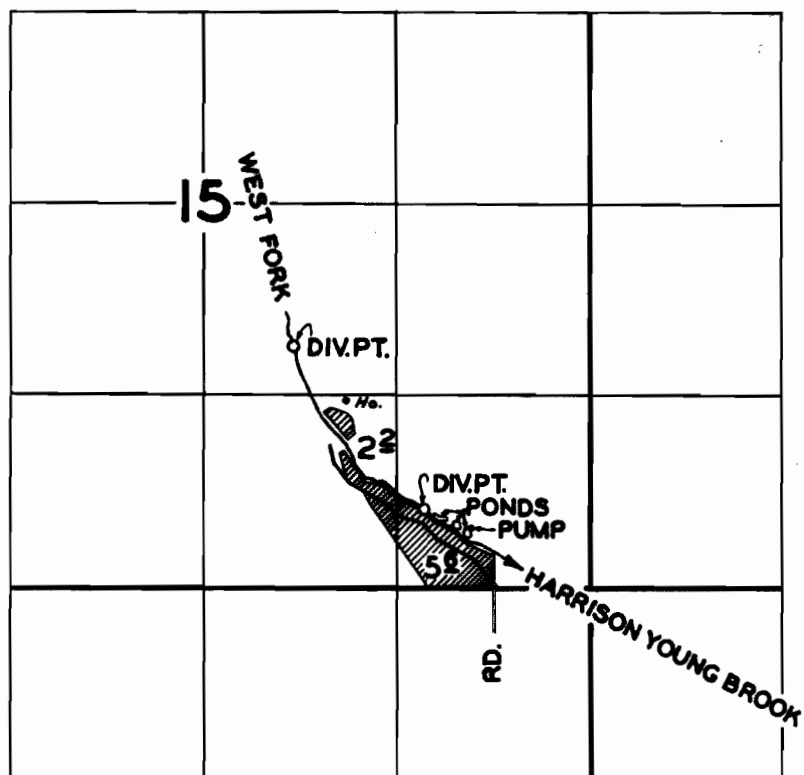

FINAL PROOF SURVEY
UNDER

Application No. 24608 Permit No. 19381
IN NAME OF

Joe & Gertrude Pruitt

Surveyed JULY 29 1957, by M. Bish