T. 8 S. R. 2 W.W.M.

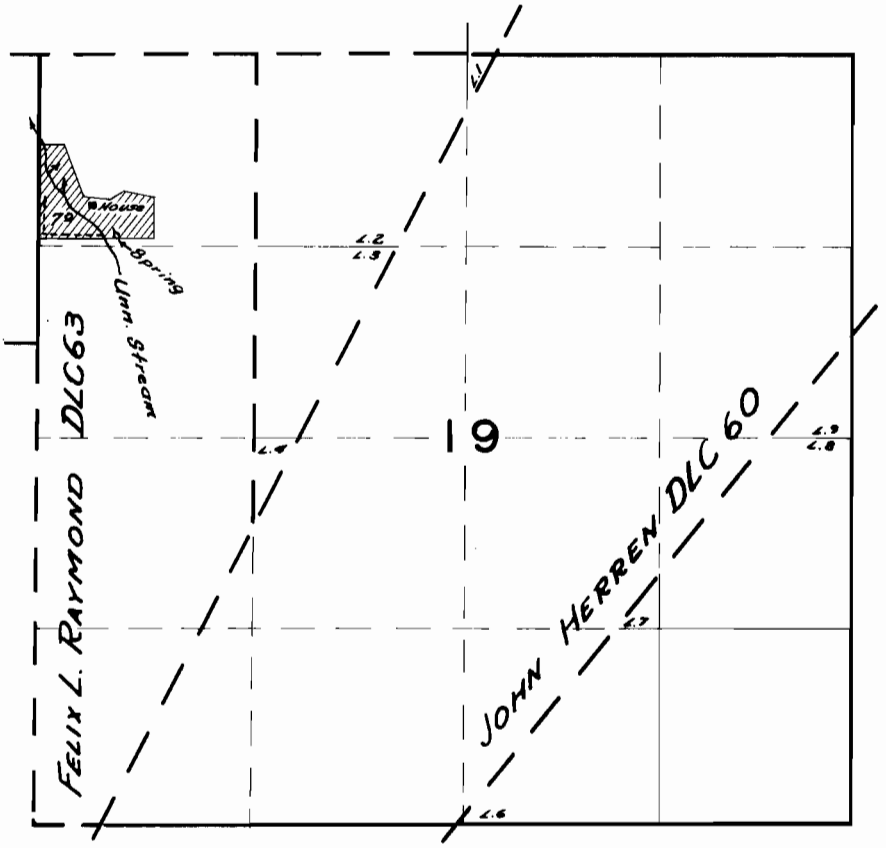

FINAL PROOF SURVEY

UNDER

Application No. 24650 Permit No. 19475

IN NAME OF

J. K. CLOYD

Surveyed May 22 1956, by R. H. Whitby

DFN-3D-133

CB