


T.13S.R.10W.W.M.

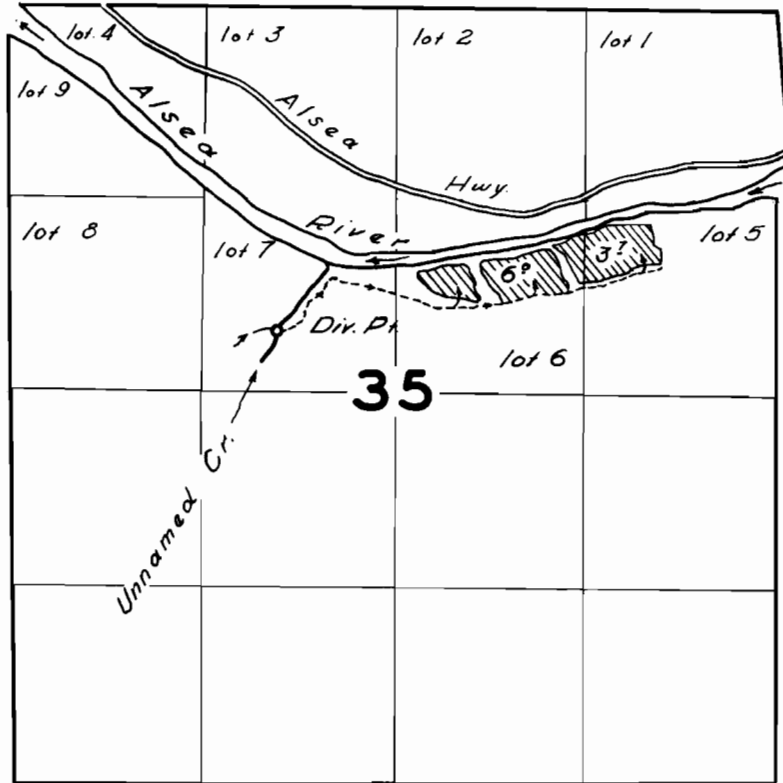

FINAL PROOF SURVEY

UNDER

Application No. 25520 Permit No. 20047

IN NAME OF

J. C. BARCLAY

Surveyed 17 June 1957, by [Signature]