


T. 7 S. R. 4 W. W. M.

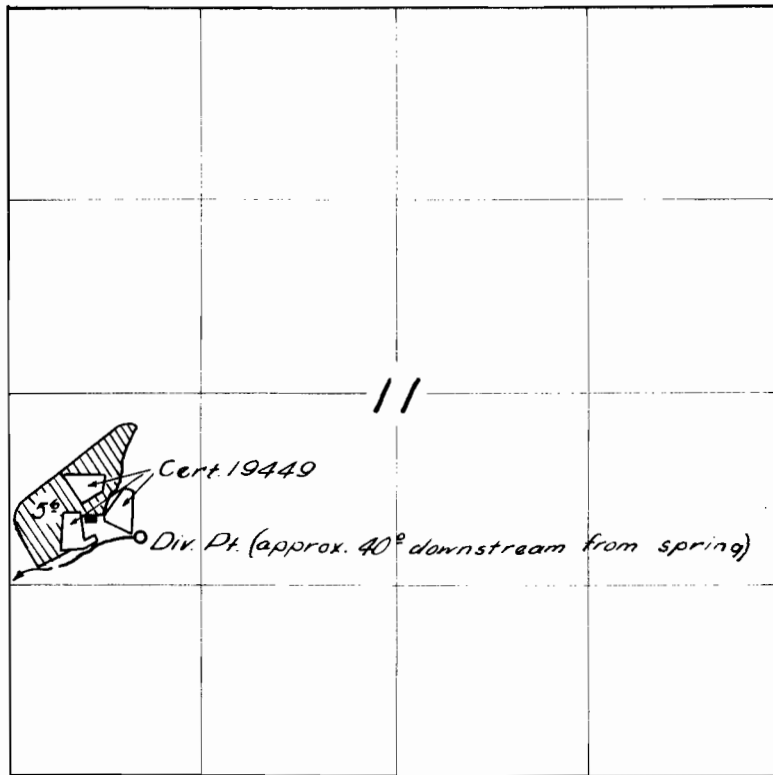

FINAL PROOF SURVEY

UNDER

Application No. 25547 Permit No. 20060

IN NAME OF

FRANK C. FITTS

Surveyed 21 Mar. 1957, by [Signature]