


T.10 S. R. 1 W. W.M.

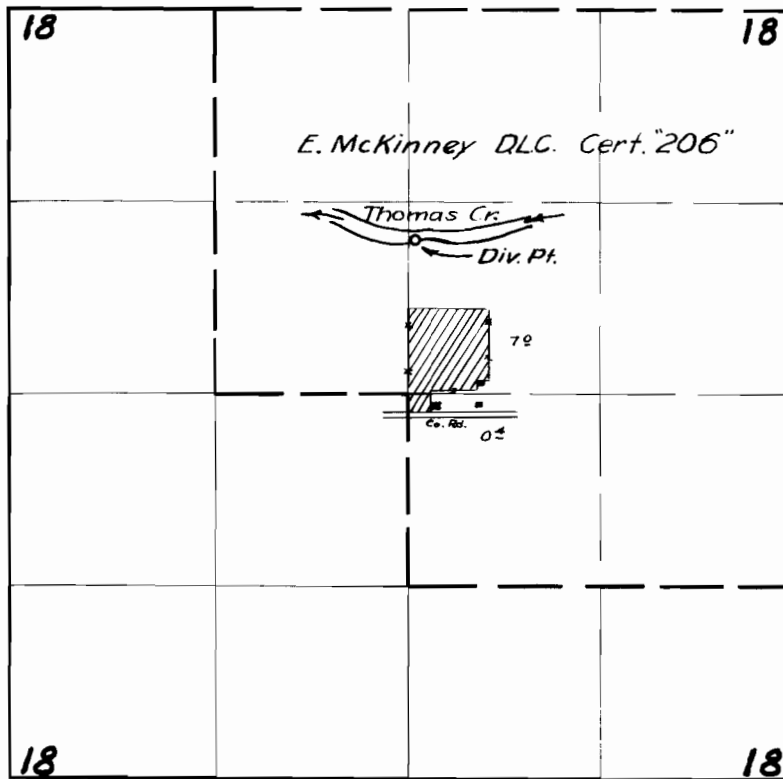

**FINAL PROOF SURVEY**

UNDER

Application No. 25666 Permit No. 20125

IN NAME OF

B.W. & Pearl Prinson

Surveyed Mar. 19, 1957, by M. Bish