


T.18S.R.11W.W.M.

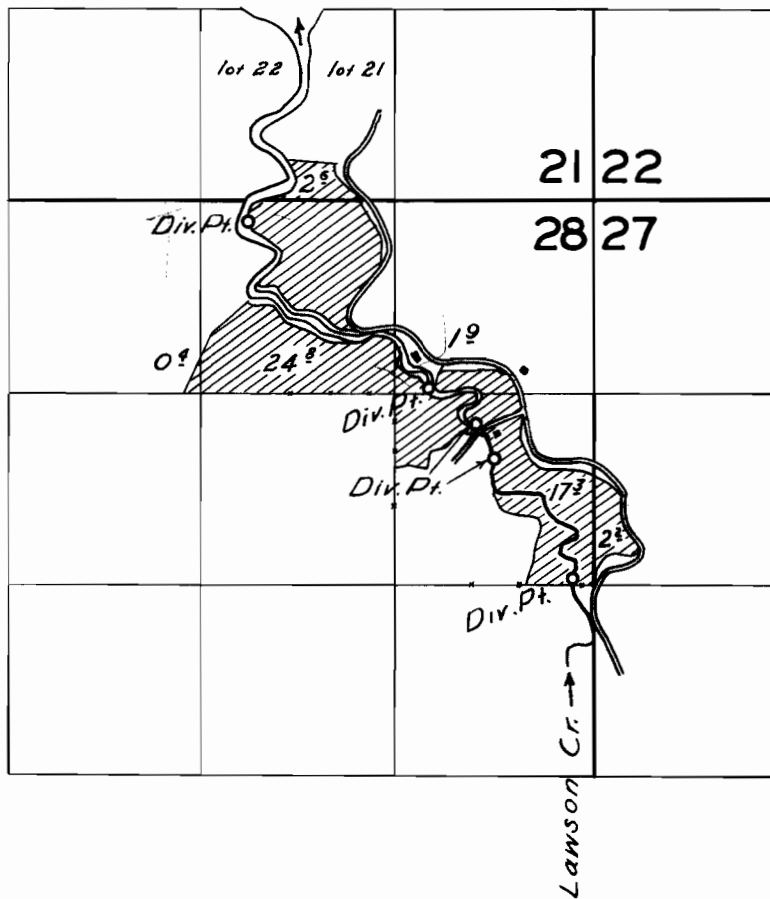

**FINAL PROOF SURVEY**  
UNDER

Application No. 25659 Permit No. 20236  
IN NAME OF

*RALPH BERNHARDT & SONS*

Surveyed 13 June 1957, by *[Signature]*