


T.17S.R.6W.W.M.

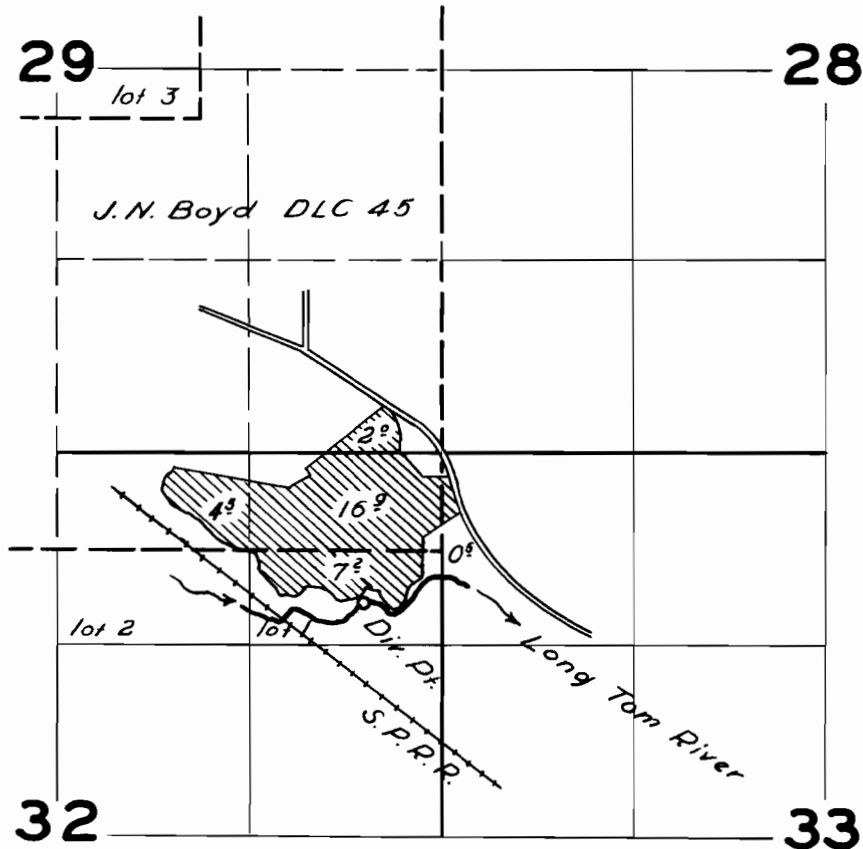

FINAL PROOF SURVEY

UNDER

Application No. 25754 Permit No. 20267

IN NAME OF

A. GRAVILLE

Surveyed 2 May 1957, by [Signature]